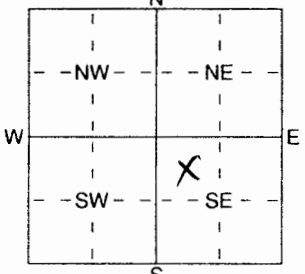


1 LOCATION OF WATER WELL: Fraction  $\frac{1}{4}$  NW  $\frac{1}{4}$  SE  $\frac{1}{4}$  Section Number 20 Township Number T 6 S Range Number R 20 **EW**

Distance and direction from nearest town or city street address of well if located within city?  
4 miles southwest of Atchison, KS

2 WATER WELL OWNER: ContiGroup Companies  
RR#, St. Address, Box # : U.S. Highway 59 West  
City, State, ZIP Code : Atchison, KS 66002  
Board of Agriculture, Division of Water Resource:  
Application Number:

3 LOCATE WELL'S LOCATION WITH AN "X" IN SECTION BOX:  


4 DEPTH OF COMPLETED WELL 33' ft. ELEVATION: 1059.55 (GROUND)  
Depth(s) Groundwater Encountered 1 22'-34' ft. 2 ft. 3 ft.  
WELL'S STATIC WATER LEVEL 10.2 ft. below land surface measured on mo/day/yr 8/11/06  
Pump test data: Well water was \_\_\_\_\_ ft. after \_\_\_\_\_ hours pumping \_\_\_\_\_ gpr  
Est. Yield UNK gpm: Well water was \_\_\_\_\_ ft. after \_\_\_\_\_ hours pumping \_\_\_\_\_ gpr  
WELL WATER TO BE USED AS: 5 Public water supply 8 Air conditioning 11 Injection well  
1 Domestic 3 Feedlot 6 Oil field water supply 9 Dewatering 12 Other (Specify below)  
2 Irrigation 4 Industrial 7 Domestic (lawn & garden) 10 Monitoring well  
Was a chemical/bacteriological sample submitted to Department? Yes **No**; If yes, mo/day/yr sample was submitted  
Water Well Disinfected? Yes **No**

5 TYPE OF BLANK CASING USED:  
1 Steel 3 RMP (SR) 5 Wrought iron 8 Concrete tile CASING JOINTS: Glued \_\_\_\_\_ Clamped \_\_\_\_\_  
2 PVC 4 ABS 6 Asbestos-Cement 9 Other (specify below) Welded \_\_\_\_\_  
7 Fiberglass Threaded   
Blank casing diameter 2 in. to 23 ft., Dia \_\_\_\_\_ in. to \_\_\_\_\_ ft., Dia \_\_\_\_\_ in. to \_\_\_\_\_ ft.  
Casing height above land surface -0.5 ft., weight \_\_\_\_\_ lbs./ft. Wall thickness or guage No. sch 40  
TYPE OF SCREEN OR PERFORATION MATERIAL:  
1 Steel 3 Stainless Steel 5 Fiberglass 8 RMP (SR) 10 Asbestos-Cement  
2 Brass 4 Galvanized Steel 6 Concrete tile 9 ABS 11 Other (Specify) \_\_\_\_\_  
12 None used (open hole) \_\_\_\_\_  
SCREEN OR PERFORATION OPENINGS ARE:  
1 Continuous slot 3 Mill slot 5 Gauzed wrapped 8 Saw cut 11 None (open hole)  
2 Louvered shutter 4 Key punched 6 Wire wrapped 9 Drilled holes 10 Other (specify) 0.01 slot ft.  
7 Torch cut  
SCREEN-PERFORATED INTERVALS: From 23 ft. to 33 ft., From \_\_\_\_\_ ft. to \_\_\_\_\_ ft.  
GRAVEL PACK INTERVALS: From 21 ft. to 33 ft., From \_\_\_\_\_ ft. to \_\_\_\_\_ ft.  
From 19 ft. to 21 ft., From \_\_\_\_\_ ft. to \_\_\_\_\_ ft.  
Beatonite

6 GROUT MATERIAL: 1 Neat cement 2 Cement grout 3 Bentonite 4 Other \_\_\_\_\_  
Grout Intervals: From 10.5 ft. to 19 ft., From \_\_\_\_\_ ft. to \_\_\_\_\_ ft., From \_\_\_\_\_ ft. to \_\_\_\_\_ ft.  
What is the nearest source of possible contamination:  
1 Septic tank 4 Lateral lines 7 Pit privy 10 Livestock pens 14 Abandoned water well  
2 Sewer lines 5 Cess pool 8 Sewage lagoon 11 Fuel storage 15 Oil well/Gas well  
3 Watertight sewer lines 6 Seepage pit 9 Feedyard 12 Fertilizer storage 16 Other (specify below)  
13 Insecticide storage \_\_\_\_\_  
Direction from well? \_\_\_\_\_ How many feet? \_\_\_\_\_

FROM	TO	LITHOLOGIC LOG	FROM	TO	PLUGGING INTERVALS
0	3.5	Gravel and brown/black silty clay			
3.5	13'	Brown and grey silty clay			
13	19	Reddish brown silty clay			
19	23	Brown and grey silty clay			
23	34	Brown and grey silty clay with sand wet at 22' & 34' ✓			

7 CONTRACTOR'S OR LANDOWNER'S CERTIFICATION: This water well was (1) constructed, (2) reconstructed, or (3) plugged under my jurisdiction and was completed on (mo/day/year) 5/11/06 and this record is true to the best of my knowledge and belief. Kansas Water Well Contractor's Licence No 697 This Water Well Record was completed on (mo/day/yr) March 27, 2007 under the business name of HWS Consulting Group Inc. by (signature) Robert A. Moorme