


1 LOCATION OF WATER WELL: Fraction $\frac{1}{4}$ NW $\frac{1}{4}$ SE $\frac{1}{4}$ Section Number 20 Township Number T 6 S Range Number R 20 **EM**
 County: Atchison

Distance and direction from nearest town or city street address of well if located within city?
 4 miles southwest of Atchison, KS

2 WATER WELL OWNER: ContiGroup Companies
 RR#, St. Address, Box # : U.S. Highway 59 West Board of Agriculture, Division of Water Resources
 City, State, ZIP Code : Atchison, KS 66002 Application Number:

3 LOCATE WELL'S LOCATION WITH 4 DEPTH OF COMPLETED WELL 40 ft. ELEVATION: 7033.81 (GROUND)

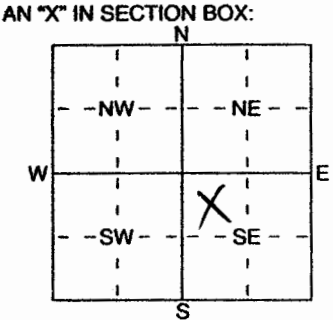

Depth(s) Groundwater Encountered 1 16 ft. 2 ft. 3 ft.
 WELL'S STATIC WATER LEVEL 3.1 ft. below land surface measured on mo/day/yr DEC 2006
 Pump test data: Well water was ft. after hours pumping gr
 Est. Yield gpm: Well water was ft. after hours pumping gr
 WELL WATER TO BE USED AS: 5 Public water supply 8 Air conditioning 11 Injection well
 1 Domestic 3 Feedlot 6 Oil field water supply 9 Dewatering 12 Other (Specify below)
 2 Irrigation 4 Industrial 7 Domestic (lawn & garden) 10 Monitoring well

Was a chemical/bacteriological sample submitted to Department? Yes **No**; If yes, mo/day/yr sample was submitted
 Water Well Disinfected? Yes **No**

5 TYPE OF BLANK CASING USED: 1 Steel 2 PVC 3 RMP (SR) 4 ABS 5 Wrought iron 6 Asbestos-Cement 7 Fiberglass 8 Concrete tile 9 Other (specify below) CASING JOINTS: Glued Clamped Welded Threaded

Blank casing diameter 2 in to 24 ft. Dia in to lbs./ft. Wall thickness or guage No. SCH 40
 Casing height above land surface -6 in., weight

TYPE OF SCREEN OR PERFORATION MATERIAL: 1 Steel 2 Brass 3 Stainless Steel 4 Galvanized Steel 5 Fiberglass 6 Concrete tile 7 PVC 8 RMP (SR) 9 ABS 10 Asbestos-Cement 11 Other (Specify) 12 None used (open hole)

SCREEN OR PERFORATION OPENINGS ARE: 1 Continuous slot 2 Louvered shutter 3 Mill slot 4 Key punched 5 Gauzed wrapped 6 Wire wrapped 7 Torch cut 8 Saw cut 9 Drilled holes 10 Other (specify) 11 None (open hole)
 0.01 SLOT

SCREEN-PERFORATED INTERVALS: From 24 ft. to 34 ft. From ft. to ft. From ft. to ft.
 GRAVEL PACK INTERVALS: From 22 ft. to 42 ft. From ft. to ft. From ft. to ft.
 BENTONITE

6 GROUT MATERIAL: 1 Neat cement 2 Cement grout 3 Bentonite 4 Other
 Grout Intervals: From 0 ft. to 18 ft. From 18 ft. to 22 ft. From ft. to ft.

What is the nearest source of possible contamination: 1 Septic tank 2 Sewer lines 3 Watertight sewer lines 4 Lateral lines 5 Cess pool 6 Seepage pit 7 Pit privy 8 Sewage lagoon 9 Feedyard 10 Livestock pens 11 Fuel storage 12 Fertilizer storage 13 Insecticide storage 14 Abandoned water well 15 Oil well/Gas well 16 Other (specify below)

Direction from well? How many feet?

FROM	TO	LITHOLOGIC LOG	FROM	TO	PLUGGING INTERVALS
0	5	SILTY CLAY, ORGANIC RICH TOPSOIL BLACK, MOIST			
5	14	SILTY CLAY BROWN MOIST			
14	37	SILTY CLAY BROWN AND GREY MEDIUM STIFF TO SOFT			
37	42	SILTY CLAY, DARK GREY			

7 CONTRACTOR'S OR LANDOWNER'S CERTIFICATION: This water well was (1) constructed, (2) reconstructed, or (3) plugged under my jurisdiction and was completed on (mo/day/year) 12/01/06 and this record is true to the best of my knowledge and belief. Kans Water Well Contractor's Licence No 694 This Water Well Record was completed on (mo/day/yr) MARCH 21, 2007 under the business name of HWS Consulting Group by (signature) Robert J. M...