

**CORRECTION(S) TO WATER WELL RECORD (WWC-5)**

(to rectify lacking or incorrect information)

County: Atchison

**Location listed as:**

Section-Township-Range: 13-6-20E

Fraction ( 1/4 1/4 1/4): None Given

**Location changed to:**

13-6S-20E

E2 NE NW

**Other changes:** Initial statements: \_\_\_\_\_

Changed to: \_\_\_\_\_

Comments: \_\_\_\_\_

verification method: Legal description, well owner's address, area road map, county ownership map, position on plat map, and mapping tool on KGS website. initials: DRS date: 6/15/2009


submitted by: Kansas Geological Survey, Data Resources Library, 1930 Constant Ave., Lawrence, KS 66047-3726

to: Kansas Dept of Health & Environment, Bureau of Water, 1000 SW Jackson, Suite 420, Topeka, KS 66612-1367.

1 LOCATION OF WATER WELL:	Fraction	Section Number	Township Number	Range Number
County: <u>Atchison</u>	<u>1/4</u> 1/4 1/4	<u>13</u>	<u>6</u>	<u>20</u> <span style="border: 1px solid black; border-radius: 50%; padding: 2px;">EW</span>

Distance and direction from nearest town or city street address of well if located within city?

2 WATER WELL OWNER: Gregory R. Morrison  
 RR #, St. Address, Box #: 6724 US Hwy 73  
 City, State, ZIP Code : Atchison, KS 66012  
 Board of Agriculture, Division of Water Resources  
 Application Number: \_\_\_\_\_

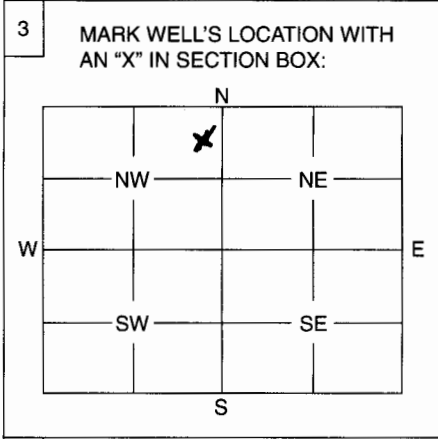

4 DEPTH OF WELL ..... 26 ..... ft.  
 WELL'S STATIC WATER LEVEL ..... 8.6 ..... ft.

WELL WAS USED AS:

1 Domestic	5 Public Water Supply	9 Dewatering
2 Irrigation	6 Oil Field Water Supply	10 Monitoring Well
<u>3 Feedlot</u>	7 Domestic (Lawn & Garden)	11 Injection Well
4 Industrial	8 Air Conditioning	12 Other .....

Was a chemical / bacteriological sample submitted to Department? Yes ..... No

If yes, mo/day/yr sample was submitted .....

Water Well Disinfected: Yes  No .....

5 TYPE OF BLANK CASING USED:

1 Steel	3 RMP (SR)	5 Wrought	7 Fiberglass	<u>9 Other (Specify below)</u> <u>Red Clay Tile</u>
2 PVC	4 ABS	6 Asbestos-Cement	8 Concrete Tile	

Blank casing diameter ..... 8" ..... in. Was casing pulled? Yes  No ..... If yes, how much ..... 3' .....

Casing height above or below land surface ..... 3.6 ..... in.

6 GROUT PLUG MATERIAL: 1 Neat cement 2 Cement grout 3 Bentonite 4 Other .....

Grout Plug Intervals: From 6.2 ft. to 3.2 ft., From 2.2 ft. to 0 ft., From ..... to ..... ft.

What is the nearest source of possible contamination:

1 Septic tank	6 Seepage pit	11 Fuel storage	16 Other (specify below)
2 Sewer lines	7 Pit privy	12 Fertilizer storage	
3 Watertight sewer lines	<u>8 Sewage lagoon</u>	13 Insecticide storage	
4 Lateral lines	9 Feedyard	14 Abandoned water well	
5 Cess pool	10 Livestock pens	15 Oil well/Gas well	

Direction from well? ..... N ..... How many feet? ..... 10 .....

FROM	TO	PLUGGING MATERIALS
<u>26'</u>	<u>17.6'</u>	<u>Sand</u>
<u>17.6'</u>	<u>6.2'</u>	<del>Sand</del> <u>Fill Material</u>
<u>6.2'</u>	<u>3.2'</u>	<u>Bentonite Clay Plug</u>
<u>3.2'</u>	<u>2.2'</u>	<u>Fill Material</u>
<u>2.2'</u>	<u>0'</u>	<u>Bentonite Clay Mushroom Plug</u>

7 CONTRACTOR'S OF LANDOWNER'S CERTIFICATION: This water well was plugged under my jurisdiction and was completed on (mo/day/year) ..... and this record is true to the best of my knowledge and belief. Kansas Water Well Contractor's License No. .... This Water Well Record was completed on (mo/day/year) ..... under the business name of ..... by (signature) ..... Gregory R. Morrison Individual .....

INSTRUCTIONS: Use typewriter or ball point pen. Please press firmly and print clearly. Please fill in blanks, underline or circle the correct answers. Send top three copies to Kansas Department of Health and Environment, Bureau of Water, Geology Section, 1000 SW Jackson St., Ste. 420, Topeka, Kansas 66612-1367. Telephone: 785/296-5522. Send one to Water Well Owner and retain one for your records.