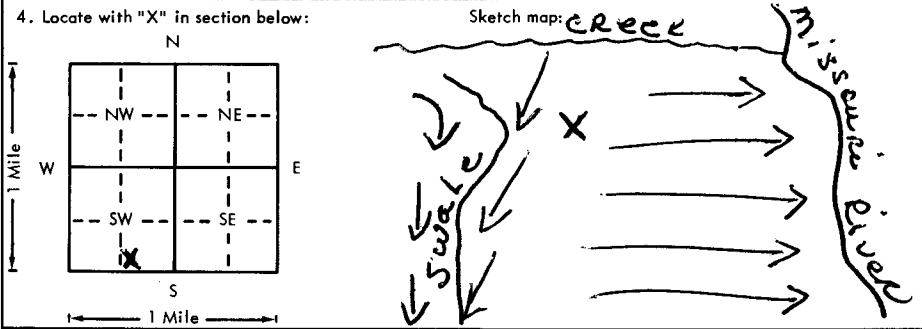


USE TYPEWRITER OR BALL  
POINT PEN—PRESS FIRMLY,  
PRINT CLEARLY.

WATER WELL RECORD  
KSA 82a-1201-1215

Kansas Department of Health and  
Environment—Division of Environment  
(Water well Contractors)  
Topeka, Kansas 66620

1. Location of well:		County <b>Atchison</b>	Fraction <b>SE 1/4 SW 1/4 SE 1/4 SW 1/4</b>	Section number <b>27</b>	Township number <b>T 6S</b>	Range number <b>S R 21E</b>
2. Distance and direction from nearest town or city: <b>7 miles South &amp; 2 1/2 East of Atchison, Ks.</b> Street address of well location if in city:				3. Owner of well: <b>Harold Rice &amp; John Hertzog</b> R.R. or street: <b>Box 328</b> City, state, zip code: <b>Lees Summit, Mo. 64063</b>		
4. Locate with "X" in section below: 				6. Bore hole dia. <b>30</b> in. Completion date <b>6-8-77</b> Well depth <b>89</b> ft.		
5. Type and color of material				7. <input type="checkbox"/> Cable tool <input type="checkbox"/> Rotary <input type="checkbox"/> Driven <input type="checkbox"/> Dug <input type="checkbox"/> Hollow rod <input type="checkbox"/> Jetted <input type="checkbox"/> Bored <input checked="" type="checkbox"/> Reverse rotary		
Light brown soil				8. Use: <input type="checkbox"/> Domestic <input type="checkbox"/> Public supply <input type="checkbox"/> Industry <input checked="" type="checkbox"/> Irrigation <input type="checkbox"/> Air conditioning <input type="checkbox"/> Stock <input type="checkbox"/> Lawn <input type="checkbox"/> Oil field water <input type="checkbox"/> Other		
Med. gray gravel & gray clay				9. Casing: Material <b>Trans.</b> Height: Above or below Threaded <input type="checkbox"/> Welded <input type="checkbox"/> Surface <b>24"</b> in. RMP <input type="checkbox"/> PVC <input type="checkbox"/> Weight <input type="checkbox"/> lbs./ft. Dia. <b>16</b> in. to <b>50</b> ft. depth Wall Thickness: inches or Dia. <input type="checkbox"/> in. to <input type="checkbox"/> ft. depth gage No. <b>.75"</b>		
Med. to large gray gravel				10. Screen: Manufacturer's name <b>Johnson WellCo.</b> Type <b>Transite</b> Dia. <b>16"</b> Slot/gauze <b>1/8 x 8</b> Length <b>39'</b> Set between <b>50</b> ft. and <b>89</b> ft. Gravel pack? <b>yes</b> Size range of material <b>1/8-1/4"</b>		
Med. to large gray gravel & wood				11. Static water level: <input type="checkbox"/> mo./day/yr. <b>15</b> ft. below land surface Date <b>6-3-77</b>		
Clay & wood				12. Pumping level below land surfaces: <b>20</b> ft. after <b>1</b> hrs. pumping <b>1000</b> g.p.m. <b>25</b> ft. after <b>3</b> hrs. pumping <b>1500</b> g.p.m. Estimated maximum yield <b>2500</b> g.p.m.		
Small gray gravel & clay				13. Water sample submitted: <input type="checkbox"/> mo./day/yr. <input type="checkbox"/> Yes <input checked="" type="checkbox"/> No Date <input type="checkbox"/>		
Gray clay & wood				14. Well head completion: <input type="checkbox"/> Pitless adapter <input type="checkbox"/> Inches above grade		
Wood & fine gray sand				15. Well grouted? <b>yes</b> With: <input type="checkbox"/> Neat cement <input type="checkbox"/> Bentonite <input checked="" type="checkbox"/> Concrete Depth: From <b>0</b> ft. to <b>10</b> ft.		
Small to med. gray gravel				16. Nearest source of possible contamination: ft. <b>200</b> Direction <b>west</b> Type <b>swale</b> Well disinfected upon completion? <input type="checkbox"/> Yes <input checked="" type="checkbox"/> No		
Med. to large gray gravel				17. Pump: <input checked="" type="checkbox"/> Not installed Manufacturer's name <input type="checkbox"/> Model number <input type="checkbox"/> HP <input type="checkbox"/> Volts <input type="checkbox"/> Length of drop pipe <input type="checkbox"/> ft. capacity <input type="checkbox"/> g.p.m. Type: <input type="checkbox"/> Submersible <input type="checkbox"/> Turbine <input type="checkbox"/> Jet <input type="checkbox"/> Reciprocating <input type="checkbox"/> Centrifugal <input type="checkbox"/> Other		
Med. to large gray gravel				20. Water well contractor's certification: This well was drilled under my jurisdiction and this report is true to the best of my knowledge and belief. Business name <input type="checkbox"/> License No. <input type="checkbox"/> Address <input type="checkbox"/> Signed <input type="checkbox"/> Date <input type="checkbox"/> Authorized representative		
Large to extra large gray gravel						
Black coally wood						
Very fine sand						
Small gray gravel						
See next page-- (Use a second sheet if needed)						
18. Elevation: <b>780'</b> Topography: <input type="checkbox"/> Hill <input type="checkbox"/> Slope <input type="checkbox"/> Upland <input type="checkbox"/> Valley		19. Remarks:				

Forward the white, blue and pink copies to the Department of Health and Environment

Form WWC-5

USE TYPEWRITER OR BALL  
POINT PEN-PRESS FIRMLY,  
PRINT CLEARLY.

WATER WELL RECORD  
KSA 82a-1201-1215

Kansas Department of Health and  
Environment-Division of Environment  
(Water well Contractors)  
Topeka, Kansas 66620

1. Location of well:	County <b>Atchison</b>	Fraction <b>SW 1/4 SE 1/4 SW 1/4</b>	Section number <b>27</b>	Township number <b>T 6S S R 21E</b>	Range number <b>21E</b>
2. Distance and direction from nearest town or city: <b>7 miles South &amp; 2 1/2 East of Atchison, Ks.</b> Street address of well location if in city:			3. Owner of well: <b>Harold Rice &amp; John Hertzog</b> R.R. or street: <b>Box 328</b> City, state, zip code: <b>Lees Summit, Mo. 64063</b>		
4. Locate with "X" in section below:		Sketch map:		6. Bore hole dia. _____ in. Completion date _____ Well depth _____ ft.	
		7. Cable tool _____ Rotary _____ Driven _____ Dug _____ Hollow rod _____ Jetted _____ Bored _____ Reverse rotary _____ 8. Use: Domestic _____ Public supply _____ Industry _____ Irrigation _____ Air conditioning _____ Stock _____ Lawn _____ Oil field water _____ Other _____ 9. Casing: Material _____ Height: Above or below _____ Threaded _____ Welded _____ Surface _____ in. RMP _____ PVC _____ Weight _____ lbs./ft. Dia. _____ in. to _____ ft. depth Wall Thickness: inches or _____ Dia. _____ in. to _____ ft. depth gage No. _____		10. Screen: Manufacturer's name _____	
				Type _____ Dia. _____ Slot/gauze _____ Length _____ Set between _____ ft. and _____ ft. _____ ft. and _____ ft. Gravel pack? _____ Size range of material _____	
5. Type and color of material			From	To	11. Static water level: _____ mo./day/yr. _____ ft. below land surface Date _____
<b>Med. gray gravel</b>			<b>66</b>	<b>67</b>	12. Pumping level below land surfaces: _____ ft. after _____ hrs. pumping _____ g.p.m. _____ ft. after _____ hrs. pumping _____ g.p.m. Estimated maximum yield _____ g.p.m.
<b>Large gray gravel</b>			<b>67</b>	<b>88</b>	
<b>Very fine gray sand</b>			<b>88</b>	<b>89</b>	13. Water sample submitted: _____ mo./day/yr. Yes _____ No _____ Date _____
<b>Stopped.</b>			<b>89</b>		14. Well head completion: Pitless adapter _____ Inches above grade
					15. Well grouted? _____ With: Neat cement _____ Bentonite _____ Concrete _____ Depth: From _____ ft. to _____ ft.
					16. Nearest source of possible contamination: ft. _____ Direction _____ Type _____ Well disinfected upon completion? Yes _____ No _____
					17. Pump: _____ Not installed Manufacturer's name _____ Model number _____ HP _____ Volts _____ Length of drop pipe _____ ft. capacity _____ g.p.m. Type: Submersible _____ Turbine _____ Jet _____ Reciprocating _____ Centrifugal _____ Other _____
(Use a second sheet if needed)					
18. Elevation:	19. Remarks: <b>We do not install pumps.</b>		20. Water well contractor's certification: This well was drilled under my jurisdiction and this report is true to the best of my knowledge and belief. <b>Hoobler Drilling Co. 323</b> Business name License No. Address <b>St. Marys, Ks. 66536</b> Signed <i>Don Hoobler</i> Date <b>6-28-77</b> Authorized representative		
Topography: Hill _____ Slope _____ Upland _____ <input checked="" type="checkbox"/> Valley					

Forward the white, blue and pink copies to the Department of Health and Environment

Form WWC-5