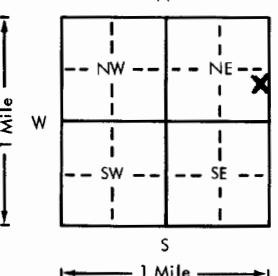
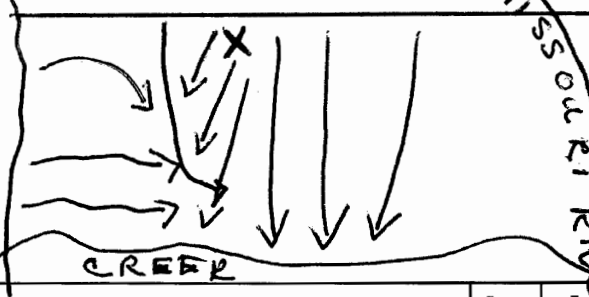


USE TYPEWRITER OR BALL
POINT PEN-PRESS FIRMLY,
PRINT CLEARLY.

WATER WELL RECORD
KSA 82a-1201-1215

Kansas Department of Health and
Environment-Division of Environment
(Water well Contractors)
Topeka, Kansas 66620

| | | | | | |
|--|---------------------------|---|---|--|---------------------------------|
| 1. Location of well: | County Atchison | Fraction NE 1/4 SE 1/4 NE 1/4 | Section number 28 | Township number T 6S S | Range number R 21E EW |
| 2. Distance and direction from nearest town or city: 7 miles South & 2 1/2 East of Atchison, Ks. Street address of well location if in city: | | | 3. Owner of well: Harold Rice & John Hertzog R.R. or street: Box 328 City, state, zip code: Lees Summit, Mo. 64063 | | |
| 4. Locate with "X" in section below: | | Sketch map: | | 6. Bore hole dia. 30 in. Completion date 6-8-77 Well depth 91 ft. | |
|  | |  | | 7. Cable tool <input type="checkbox"/> Rotary <input type="checkbox"/> Driven <input type="checkbox"/> Dug <input type="checkbox"/> Hollow rod <input type="checkbox"/> Jetted <input type="checkbox"/> Bored <input checked="" type="checkbox"/> Reverse rotary | |
| 5. Type and color of material | | From | To | 8. Use: Domestic <input type="checkbox"/> Public supply <input type="checkbox"/> Industry <input type="checkbox"/> <input checked="" type="checkbox"/> Irrigation <input type="checkbox"/> Air conditioning <input type="checkbox"/> Stock <input type="checkbox"/> Lawn <input type="checkbox"/> Oil field water <input type="checkbox"/> Other | |
| Hard brown soil | | 0 | 1 | 9. Casing: Material Transite Height: Above or below Threaded <input type="checkbox"/> Welded <input type="checkbox"/> Surface 12 in. RMP <input type="checkbox"/> PVC <input type="checkbox"/> Weight <input type="checkbox"/> lbs./ft. Dia. 16 in. to 59 ft. depth Wall Thickness: inches or Dia. <input type="checkbox"/> in. to <input type="checkbox"/> ft. depth gage No. .75 | |
| Hard black soil | | 1 | 3 | 10. Screen: Manufacturer's name Johnson Well Co. Type Transite Dia. 16 " Slot/gauze <input type="checkbox"/> Length 39 " Set between 52 ft. and 91 ft. Gravel pack? yes Size range of material 1/8-1/4 " | |
| Hard brown silty soil | | 3 | 8 | 11. Static water level: <input type="checkbox"/> mo./day/yr. 11 ft. below land surface Date 6-8-77 | |
| Small gray gravel | | 8 | 30 | 12. Pumping level below land surfaces: 14 ft. after 1 hrs. pumping 1000 g.p.m. 16 ft. after 3 hrs. pumping 1500 g.p.m. Estimated maximum yield 3000 g.p.m. | |
| Large gray gravel | | 30 | 34 | 13. Water sample submitted: <input type="checkbox"/> mo./day/yr. <input type="checkbox"/> Yes <input checked="" type="checkbox"/> No Date | |
| Small gray gravel | | 34 | 49 | 14. Well head completion: <input type="checkbox"/> Pitless adapter <input type="checkbox"/> Inches above grade | |
| Small gray gravel & gray clay | | 49 | 51 | 15. Well grouted? yes With: Neat cement <input type="checkbox"/> Bentonite <input checked="" type="checkbox"/> Concrete <input type="checkbox"/> Depth: From 0 ft. to 10 ft. | |
| Small to med. gray gravel | | 51 | 52 | 16. Nearest source of possible contamination: ft. 1600 Direction south Type creek Well disinfected upon completion? <input type="checkbox"/> Yes <input checked="" type="checkbox"/> No | |
| Large gray gravel | | 52 | 58 | 17. Pump: <input checked="" type="checkbox"/> Not installed Manufacturer's name <input type="checkbox"/> Model number <input type="checkbox"/> HP <input type="checkbox"/> Volts <input type="checkbox"/> Length of drop pipe <input type="checkbox"/> ft. capacity <input type="checkbox"/> g.p.m. Type: <input type="checkbox"/> Submersible <input type="checkbox"/> Turbine <input type="checkbox"/> Jet <input type="checkbox"/> Reciprocating <input type="checkbox"/> Centrifugal <input type="checkbox"/> Other | |
| Large gray gravel & gray clay | | 58 | 65 | 18. Elevation: 700 Topography: <input type="checkbox"/> Hill <input type="checkbox"/> Slope <input type="checkbox"/> Upland <input checked="" type="checkbox"/> Valley | |
| Med. to large gray gravel & clay | | 65 | 91 | 19. Remarks: We do not install pumps. | |
| Stopped. | | 91 | | 20. Water well contractor's certification: This well was drilled under my jurisdiction and this report is true to the best of my knowledge and belief. Hobler Drilling Co. 323 Business name License No. Address St. Marys, Ks. 66536 Signed Don Hobler Date 7-6-77 Authorized representative | |

Forward the white, blue and pink copies to the Department of Health and Environment

Form WWC-5