


MW-2

WATER WELL PLUGGING RECORD Form WWC-5P KSA 82a-1212 ID NO.

1 LOCATION OF WATER WELL: County: Atchison Fraction 1/4 NW 1/4 NW 1/4 NW 1/4 Section Number 6 Township Number T 6 S Range Number 21 E W

Street/Rural Address of Well Location: 405 Utah St. Atchison KS Global Positioning Systems (GPS) information: Latitude: 39.55985 Longitude: 95.11806

2 WATER WELL OWNER: Shell Oil Products US RR#, St. Address, Box #: 308 Wilcox; No. 101 City, State ZIP Code: Castle Rock CO 80404

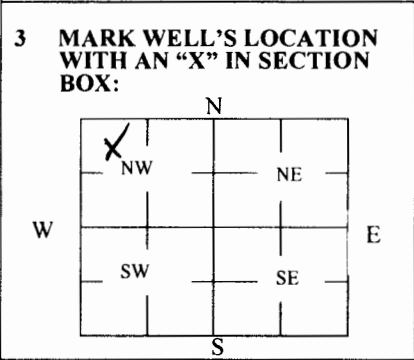

4 DEPTH OF WELL 15 ft. WELL'S STATIC WATER LEVEL _____ ft. WELL WAS USED AS: Domestic, Irrigation, Feedlot, Industrial, Public Water Supply, Oil Field Water Supply, Domestic (Lawn & Garden), Air Conditioning, Dewatering, Monitoring, Injection Well, Other

5 TYPE OF BLANK CASING USED: Steel, PVC, RMP (SR), ABS, Wrought, Asbestos-Cement, Fiberglass, Concrete Tile, Other (Specify below). Blank casing diameter 2 in. Was casing pulled? Yes No If yes, how much 5' Casing height above or below land surface 2 in.

6 GROUT PLUG MATERIAL: Neat cement, Cement grout, Bentonite, Other. Grout Plug Intervals: From 2 ft. to 15 ft., From _____ ft. to _____ ft., From _____ ft. to _____ ft. What is the nearest source of possible contamination: Septic tank, Sewer lines, Watertight sewer lines, Lateral lines, Cess pool, Seepage pit, Pit privy, Sewage lagoon, Feedyard, Livestock pens, Fuel storage, Fertilizer storage, Insecticide storage, Abandoned water well, Oil well/Gas well, Other (specify below)

Table with columns: FROM, TO, PLUGGING MATERIALS. Row 1: 0, 2, Concrete. Row 2: 2, 15, Bentonite.

7 CONTRACTOR'S OR LANDOWNER'S CERTIFICATION: This water well was plugged under my jurisdiction and was completed on (mo/day/year) 07/30/2015 and this record is true to the best of my knowledge and belief. Kansas Water Well Contractor's License No. 710. This Water Well Record was completed on (mo/day/year) 07/31/2105 under the business name of Below Ground Surface, Inc. by (signature)

Send one white copy to Kansas Department of Health & Environment, Geology Section, 1000 SW Jackson Street, Ste. 420, Topeka, KS 66612-1367. Send one copy to WATER WELL OWNER and retain one for your records. Visit us at http://www.kdheks.gov/waterwell/index.html Telephone 785-296-5524.