


MW3RR

☐ Original Record ☐ Correction ☐ Change in Well Use

Well ID

[illegible]

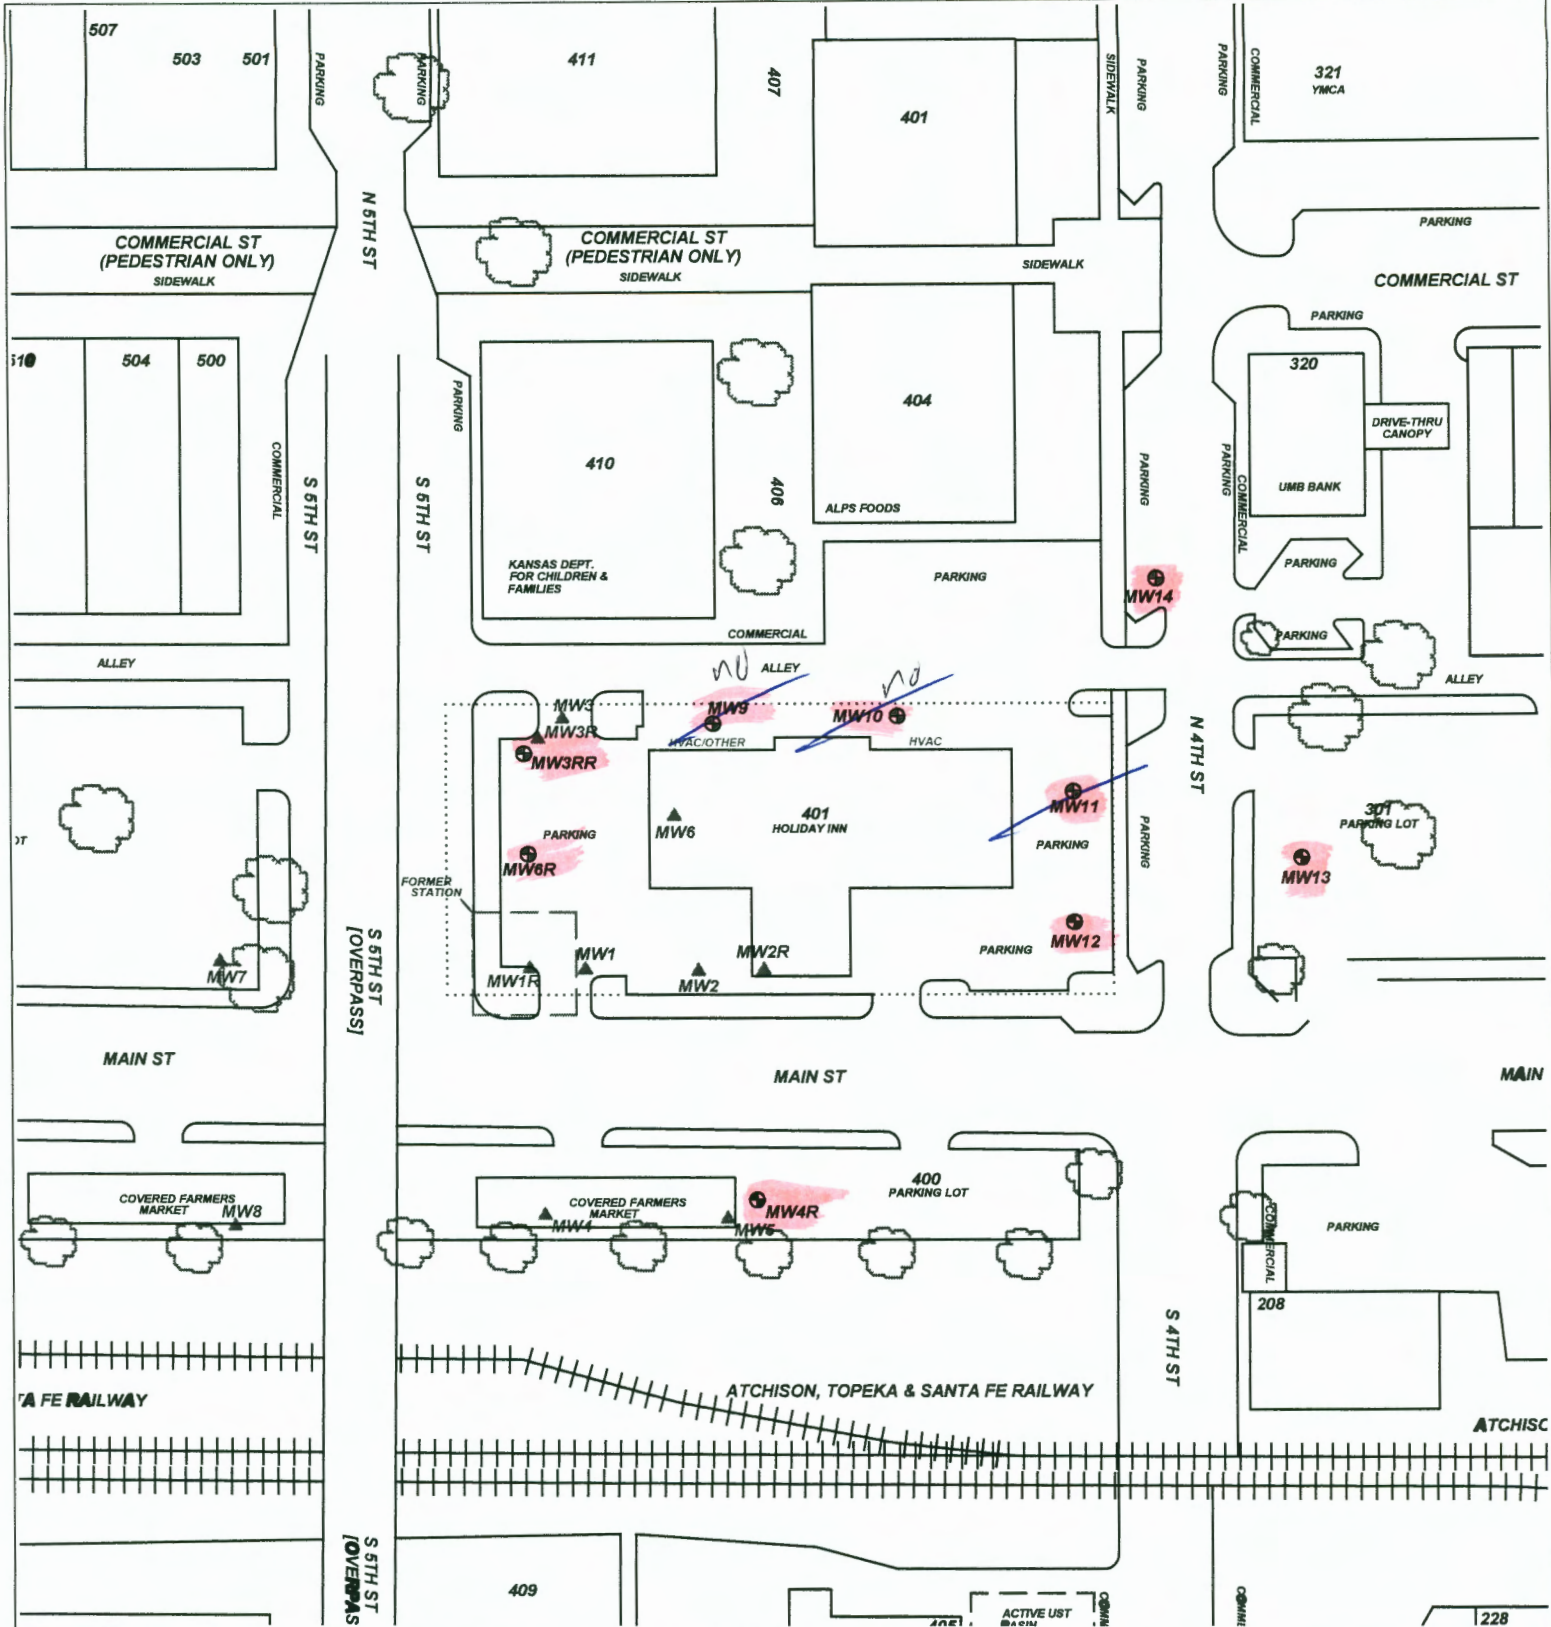

PROJECT: 401 MAIN STREET, ATCHISON

ADDRESS: 401 MAIN STREET

LOCATION: ATCHISON, KS

DRAWN BY: B. SCOTT DATE: 3/25/16

REVISED BY: B. STALNAKER DATE: 12/10/20

AEI JOB #: TM204 KDH JOB #: U4-003-14887

SCALE: 1" = 100'
0 50 100

NOTES:

TITLE: **FIGURE 2.1
SITE MAP
350' RADIUS**

**ASSOCIATED
ENVIRONMENTAL
INC.**

- LEGEND:
- = FORMER FILLING STATION
 - = MONITOR WELL
 - = PLUGGED MONITOR WELL
 - = SUBJECT PROPERTY

