


MW4R

☐ Original Record ☐ Correction ☐ Change in Well Use

Well ID

[illegible]

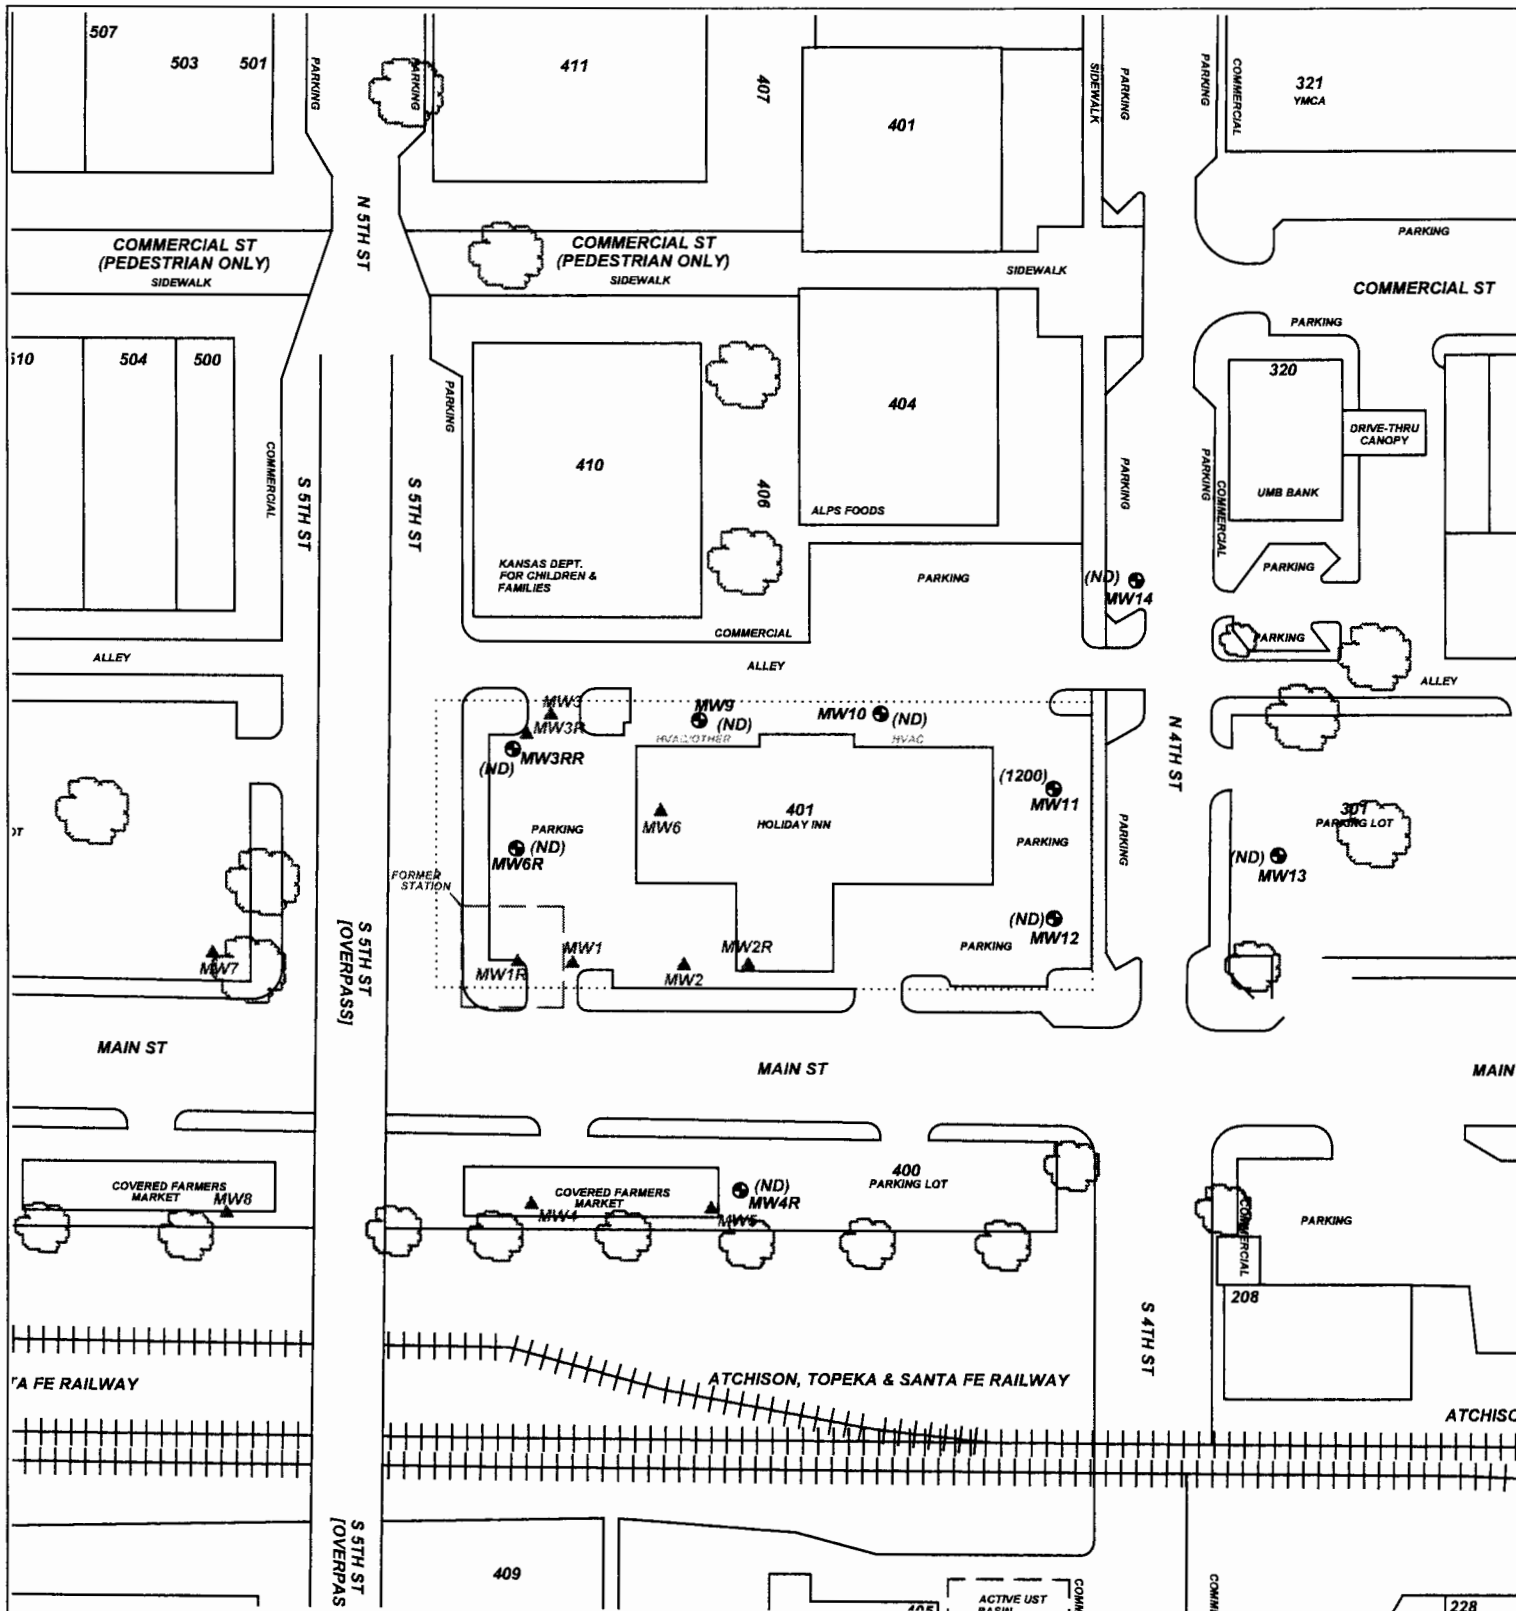

PROJECT: 401 MAIN STREET, ATCHISON

ADDRESS: 401 MAIN STREET

LOCATION: ATCHISON, KS

DRAWN BY: B. SCOTT

DATE: 3/25/16


REVISED BY: B. STALNAKER

DATE: 12/10/20

AEI JOB #: TM204

KDHE JOB #: U4-003-14887

SCALE: 1" = 100'

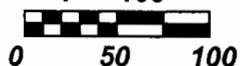

NOTES:

TITLE:

Figure 5.10 HRH in Wells



**ASSOCIATED
ENVIRONMENTAL
INC.**

LEGEND:

☐ = FORMER FILLING STATION

● = MONITOR WELL

▲ = PLUGGED MONITOR WELL

..... = SUBJECT PROPERTY

(110) = HRH conc. in ppb

(ND) = Non-Detect

(NS) = Not Sampled

