


MW3RR

☒ Original Record    ☐ Correction    ☐ Change in Well Use

Well ID

[illegible]

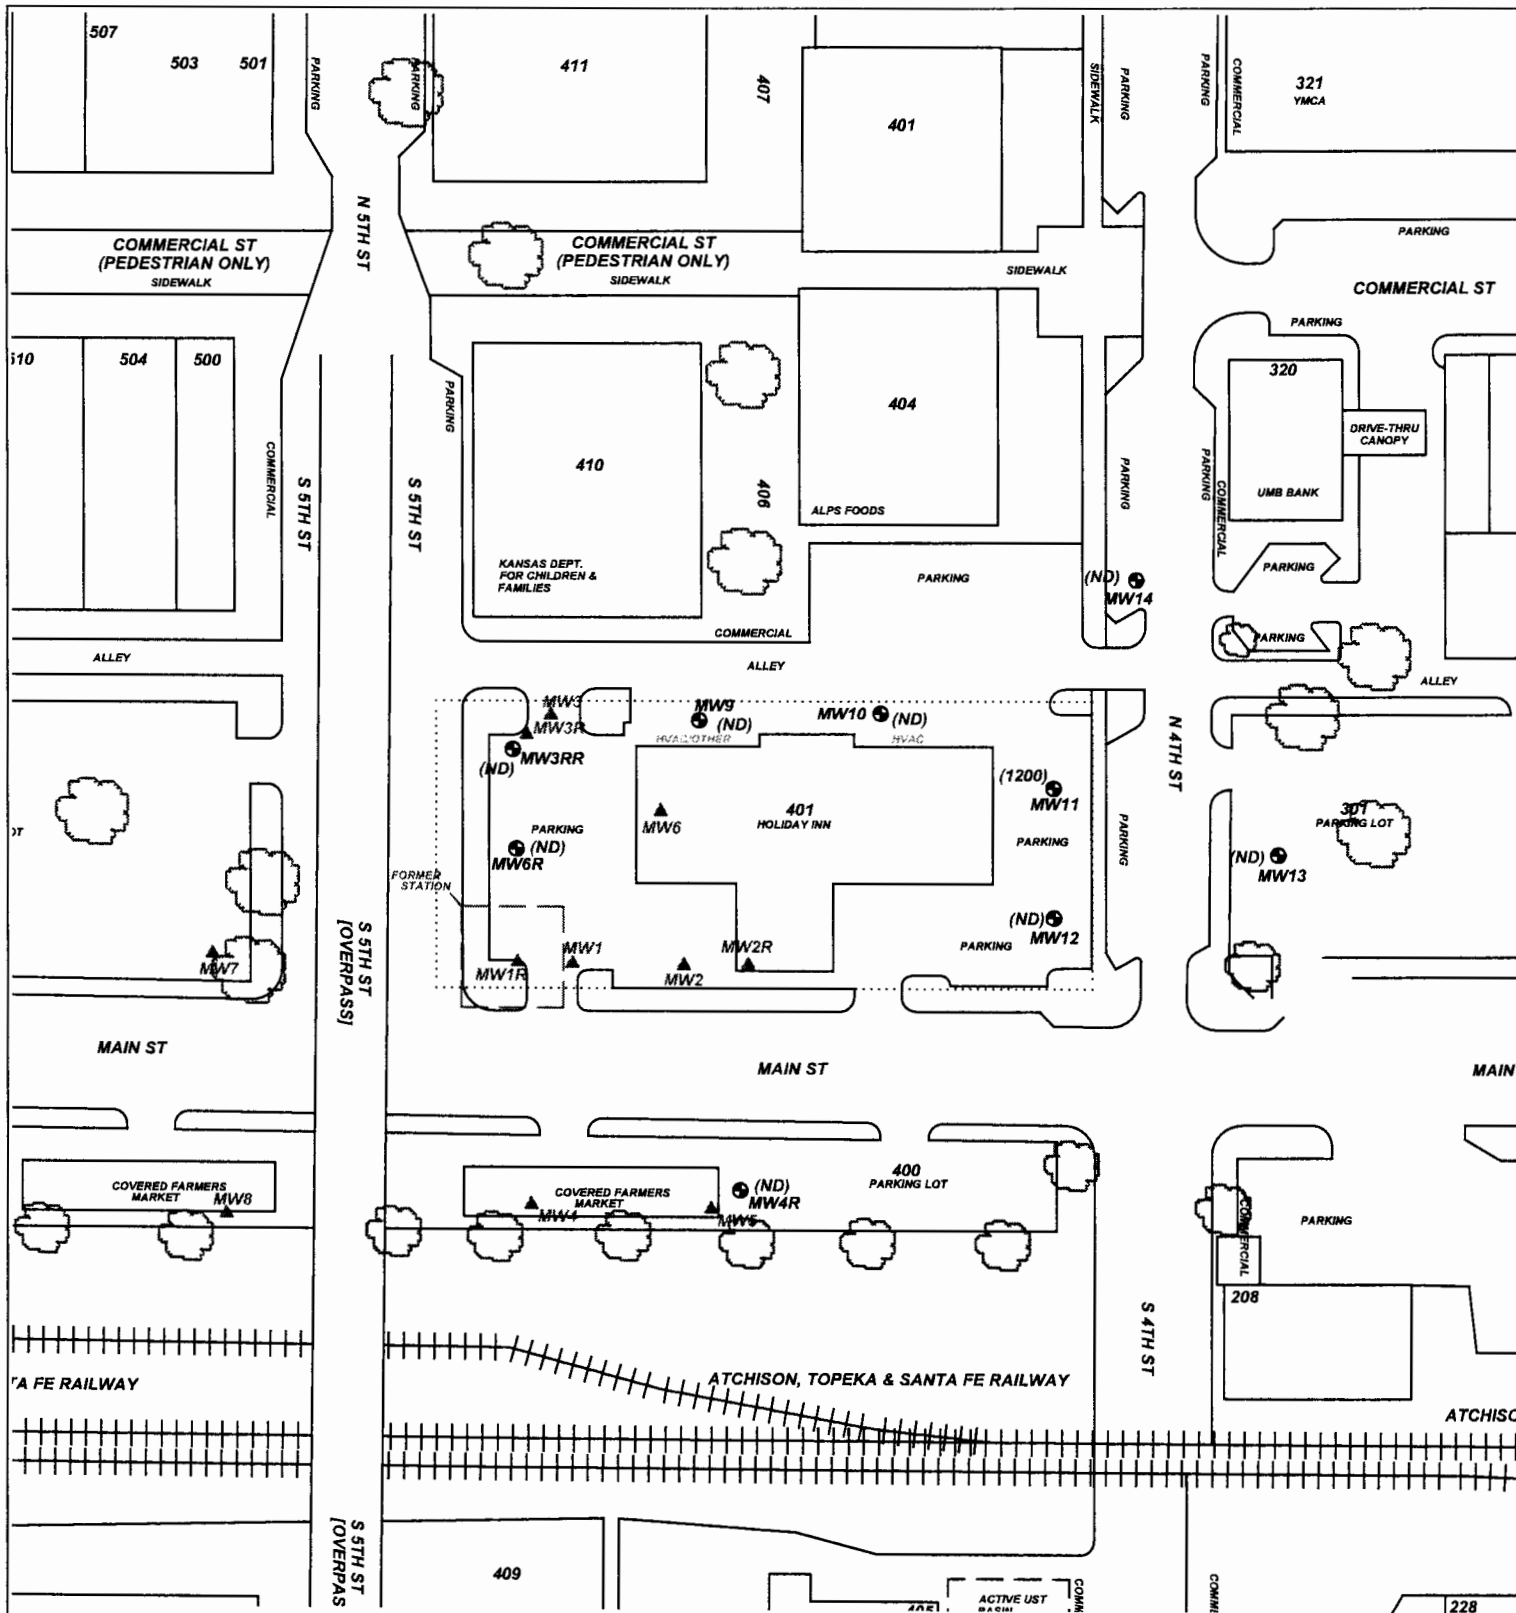

**ASSOCIATED  
ENVIRONMENTAL  
INC.**

**Figure 5.10  
HRH in Wells**