

WATER WELL PLUGGING RECORD Form WWC-5P

KSA 82a-1212

ID NO.

MW11


1 LOCATION OF WATER WELL: County: ATCHINSON	Fraction NW ¼ SW ¼ NE ¼ NW ¼	Section Number 6	Township Number T 6 S	Range Number 21 <input checked="" type="checkbox"/> E <input type="checkbox"/> W
--	--	----------------------------	---------------------------------	--

Street/Rural Address of Well Location; if unknown, distance & direction from nearest town or intersection: If at owner's address, check here **401 MAIN ST ATCHINSON, KS**

Global Positioning Systems (GPS) information:
 Latitude: **39.56114** (in decimal degrees)
 Longitude: **95.11790** (in decimal degrees)
 Elevation: **799.88**
 Horizontal Datum: WGS84, NAD83, NAD27
 Collection Method:

2 WATER WELL OWNER: KDHE
 RR#, St. Address, Box #: **1000 SW JACKSON ST**
 City, State ZIP Code: **TOPEKA, KS 66612**

GPS unit (Make/Model: _____)
 Digital Map/Photo, Topographic Map, Land Survey
 Est. Accuracy: < 3 m, 3-5 m, 5-15 m, > 15 m

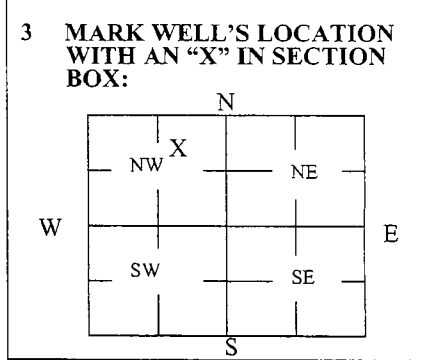

4 DEPTH OF WELL 17.81 ft.
 WELL'S STATIC WATER LEVEL 11.64 ft.
 WELL WAS USED AS:

<input type="checkbox"/> Domestic	<input type="checkbox"/> Public Water Supply	<input type="checkbox"/> Dewatering
<input type="checkbox"/> Irrigation	<input type="checkbox"/> Oil Field Water Supply	<input checked="" type="checkbox"/> Monitoring
<input type="checkbox"/> Feedlot	<input type="checkbox"/> Domestic (Lawn & Garden)	<input type="checkbox"/> Injection Well
<input type="checkbox"/> Industrial	<input type="checkbox"/> Air Conditioning	<input type="checkbox"/> Other _____

Was a chemical/bacteriological sample submitted to Department? Yes No

5 TYPE OF BLANK CASING USED:

<input checked="" type="checkbox"/> Steel	<input type="checkbox"/> RMP (SR)	<input type="checkbox"/> Wrought	<input type="checkbox"/> Fiberglass	<input type="checkbox"/> Other (Specify below) _____
<input checked="" type="checkbox"/> PVC	<input type="checkbox"/> ABS	<input type="checkbox"/> Asbestos-Cement	<input type="checkbox"/> Concrete Tile	

Blank casing diameter 2 in. Was casing pulled? Yes No If yes, how much 3 FT
 Casing height above or below land surface 36 in.

6 GROUT PLUG MATERIAL: Neat cement Cement grout Bentonite Other SOIL/ASPHALT CAP

Grout Plug Intervals: From 0.5 ft. to 3 ft., From 3 ft. to 17.81 ft., From _____ ft. to _____ ft.


What is the nearest source of possible contamination:

<input type="checkbox"/> Septic tank	<input type="checkbox"/> Seepage pit	<input type="checkbox"/> Fuel storage	<input checked="" type="checkbox"/> Other (specify below)
<input type="checkbox"/> Sewer lines	<input type="checkbox"/> Pit privy	<input type="checkbox"/> Fertilizer storage	<u>UST SITE U4-003-14887</u>
<input type="checkbox"/> Watertight sewer lines	<input type="checkbox"/> Sewage lagoon	<input type="checkbox"/> Insecticide storage	
<input type="checkbox"/> Lateral lines	<input type="checkbox"/> Feedyard	<input type="checkbox"/> Abandoned water well	Direction from well? <u>SOUTHWEST</u>
<input type="checkbox"/> Cess pool	<input type="checkbox"/> Livestock pens	<input type="checkbox"/> Oil well/Gas well	How many feet? <u>150 FT</u>

FROM	TO	PLUGGING MATERIALS	FROM	TO	PLUGGING MATERIALS
0	0.5	ASPHALT			
0.5	3	COMPACTED SILT/CLAY			
3	17.81	HYDRATED BENTONITE CHIPS			401 MAIN ST. UST SITE
					U4-003-14887

7 CONTRACTOR'S OR LANDOWNER'S CERTIFICATION: This water well was plugged under my jurisdiction and was completed on (mo/day/year) 3-1-22 and this record is true to the best of my knowledge and belief. Kansas Water Well Contractor's License No. 585. This Water Well Record was completed on (mo/day/year) 3-1-22 under the business name of ASSOCIATED ENVIRONMENTAL, INC. by (signature) [Signature]

Send one white copy to Kansas Department of Health & Environment, Geology Section, 1000 SW Jackson Street, Ste. 420, Topeka, KS 66612-1367. Send one copy to WATER WELL OWNER and retain one for your records.
 Visit us at <http://www.kdheks.gov/waterwell/index.html> Telephone 785-296-5524.

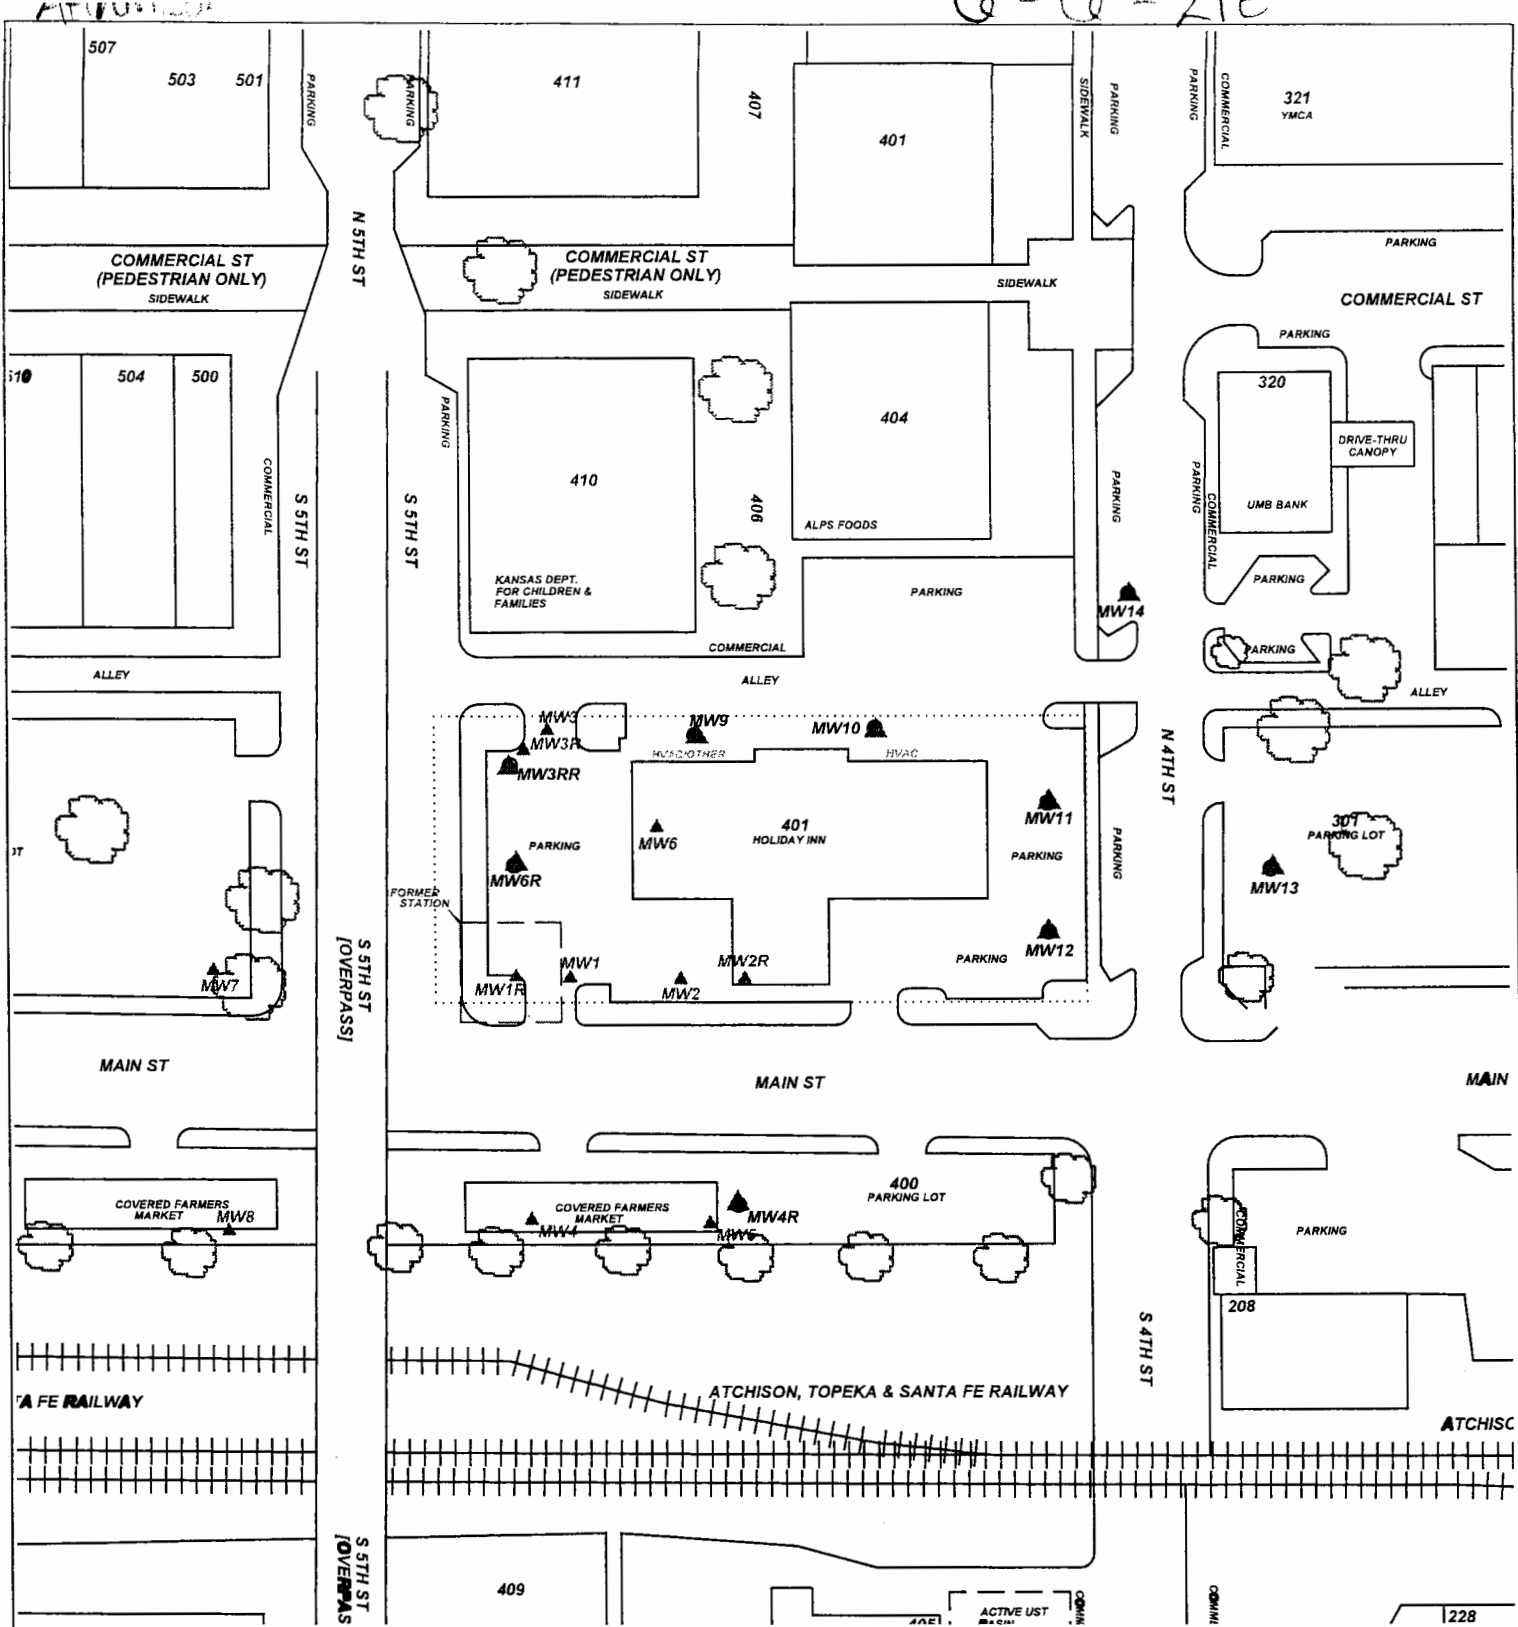

PROJECT: 401 MAIN STREET, ATCHISON

ADDRESS: 401 MAIN STREET

LOCATION: ATCHISON, KS

DRAWN BY: B. SCOTT **DATE:** 3/25/16

REVISED BY: B. STALNAKER **DATE:** 12/10/20

AEI JOB #: TM204 **KDHE JOB #:** U4-003-14887

SCALE: 1" = 100'

0 50 100

TITLE:

ASSOCIATED ENVIRONMENTAL INC.

NOTES:

LEGEND:

- = FORMER FILLING STATION
- = MONITOR WELL
- = PLUGGED MONITOR WELL
- = SUBJECT PROPERTY