


1 LOCATION OF WATER WELL: Fraction SW¹/₄ SW¹/₄ SW¹/₄ Section Number 13 Township Number 65 Range Number 30 E
 County: Clay

Distance and direction from nearest town or city street address of well if located within city? 6 1/2 miles north of Green Ko + 3 miles west 2804 Redwood Green, Ko

2 WATER WELL OWNER: Shirley Pfizenmaier
 RR #, St. Address, Box #: 720 Arthur St. Board of Agriculture, Division of Water Resources
 City, State, ZIP Code: Clay Center Ko 67432 Application Number: _____

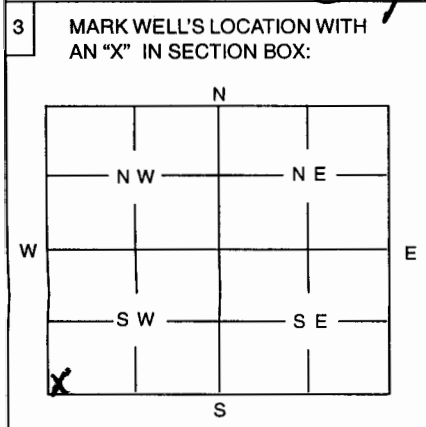

4 DEPTH OF WELL 25 ft
 WELL'S STATIC WATER LEVEL 12 ft
 WELL WAS USED AS:
 Domestic 5 Public Water Supply 9 Dewatering
 2 Irrigation 6 Oil Field Water Supply 10 Monitoring Well
 3 Feedlot 7 Domestic (Lawn & Garden) 11 Injection Well
 4 Industrial 8 Air Conditioning 12 Other
 Was a chemical / bacteriological sample submitted to Department? Yes No
 If yes, mo/day/yr sample was submitted
 Water Well Disinfected: Yes No

5 TYPE OF BLANK CASING USED:
 Steel 3 RMP (SR) 5 Wrought 7 Fiberglass 9 Other (Specify below)
 2 PVC 4 ABS 6 Asbestos-Cement 8 Concrete Tile
 Blank casing diameter 4 in. Was casing pulled? Yes No If yes, how much
 Casing height above or below land surface 4 1/2 ft below

6 GROUT PLUG MATERIAL: 1 Neat cement 2 Cement grout Bentonite 4 Other
 Grout Plug Intervals: From 10 ft. to 4 1/2 ft., From ft. to ft., From to ft.
 What is the nearest source of possible contamination:
 Septic tank 6 Seepage pit 11 Fuel storage Other (Specify below)
 2 Sewer lines 7 Pit privy 12 Fertilizer storage
 3 Watertight sewer lines 8 Sewage lagoon 13 Insecticide storage
 4 Lateral lines 9 Feedyard 14 Abandoned water well
 5 Cess Pool 10 Livestock pens 15 Oil well/Gas well
 Direction from well? North How many feet? 100+

FROM	TO	PLUGGING MATERIALS
<u>4 1/2'</u>	<u>Ground level</u>	<u>Topsoil</u>
<u>10'</u>	<u>4 1/2'</u>	<u>Bentonite well plug</u>
<u>13'</u>	<u>10'</u>	<u>compacted subsoil</u>
<u>25'</u>	<u>13'</u>	<u>gravel + disinfectant</u>

7 CONTRACTOR'S OR LANDOWNER'S CERTIFICATION: This water well was plugged under my jurisdiction and was completed on (mo/day/year) 02/03/06 and this record is true to the best of my knowledge and belief. Kansas Water Well Contractor's License No. 648 This Water Well Record was completed on (mo/day/year) 02/06/06 under the business name of Thunder Pump + Pbing LLC by (signature) Scott A. Anderson

INSTRUCTIONS: Use typewriter or ball point pen. Please press firmly and print clearly. Please fill in blanks, underline or circle the correct answers. Send top three copies to Kansas Department of Health and Environment, Bureau of Water, Topeka, Kansas 66620-0001. Telephone: 785/296-3565. Send one to Water Well Owner and retain one for your records.