A31

USE TYPEWRITER OR BALL POINT PEN-PRESS FIRMLY, PRINT CLEARLY.

T R EW sec 1/4 1/4 1/4 No.

WATER WELL RECORD
KSA 82a-1201-1215

Kansas State Dept. Of Health
(Water Well Contractors)
Forbes-Bldg. 740
Topeka, Kansas 66620

1 Location of well:	County	Township name	Fraction	Section number	Town number	Range number
	CLAY	GARFIELD	SE¼ NW¼ NE¼	21	6 S	3 E

Distance and direction from nearest town or city: 10 N 1½ E

Street address of well location if in city: CLAY CENTER

3 Owner of well: KENNETH PATTERSON

Address: CLIFTON, KANS 66937

Locate with "X" in section below:

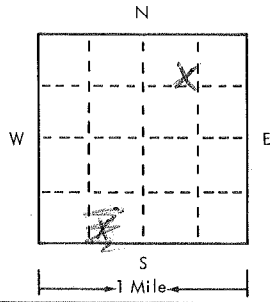

Sketch map:

4 Well depth: 40 ft. Date of completion 8/24/76
Well diameter 8 in.

5 ☐ Cable tool ☒ Rotary ☐ Driven ☐ Dug ☐ Hollow rod ☐ Jetted ☐ Bored ☐ Reverse rotary

6 Use: ☒ Domestic ☐ Public supply ☐ Industry ☐ Irrigation ☐ Air conditioning ☐ Commercial ☐ Test well ☐ _____

7 Casing: Material PVC Height: above/below
Threaded ☐ Welded ☒ Surface 12 in.
Diam. Weight 3 lbs./ft.
5 in. to 40 ft. depth Drive shoe? ☐ Yes ☐ No
___ in. to ___ ft. depth

8 Screen:
Manufacturer PUMPCO
Type PVC Dia. 5"
Slot/gauze 40 Length 20'
Set between 20 ft. and 40 ft.
Fittings:
Gravel pack ☒ Yes ☐ No Size range of material 4 X 4

9 Static water level:
25 ft. below land surface Date 8/24/76

10 Pumping level below land surfaces:
___ ft. after N/A hrs. pumping ___ g.p.m.
___ ft. after ___ hrs. pumping ___ g.p.m.
Estimated maximum yield 10 g.p.m.

11 Water sample submitted:
☐ Yes ☒ No Date ___

12 Well head completion:
☐ Pitless adapter ☒ Inches above grade

13 Well grouted? ☒ Yes ☐ No
☒ Neat cement ☐ Bentonite ☐ _____
Depth: From 0 ft. to 10 ft.

14 Nearest source of possible contamination: LOTS
ft. 400 Direction N W Type _____
Well disinfected upon completion? ☒ Yes ☐ No

15 Pump: ☒ Not installed
Manufacturer's name _____
Model number _____ HP _____ Volts _____
Length of drop pipe _____ ft. capacity _____ g.m.p.
Type:
☐ Submersible ☐ Turbine
☐ Jet ☐ Reciprocating
☐ Centrifugal ☐ Other

2 Type and color of material	From	To
TOPSOIL	0	3
BROWN CLAY	3	6
BLACK CLAY	6	11
BROWN CLAY	11	16
SANDY CLAY	16	21
SANDROCK	21	29
BROWN CLAY	29	40
STOP	40	
(use a second sheet if needed)		

16 Remarks: elevation
1345

Topography:
☐ Hill
☐ Slope
☒ Upland
☐ Valley

17 Water well contractor's certification:
This well was drilled under my jurisdiction and this report is true to the best of my knowledge and belief.

Geo Cox & Sons Inc 258
Business name License No.

Address Clifton Kans

Signed _____ Date 8/24/76
Authorized representative

Forward the white, blue and pink copies to the Kansas State Dept. Of Health.

Form WWC-5

677-H

6 3E 21 SENWNE