


1 LOCATION OF WATER WELL: County: **RILEY** Fraction: **SW 1/4 SW 1/4 SE 1/4** Section Number: **4** Township Number: **T 6S** Range Number: **R 5E**

Distance and direction from nearest town or city street address of well if located within city?
Barnes 10 mi South to Paralell 1 mi West 1 mi south to ober Kans

2 WATER WELL OWNER: **United Methodist Church By Phillip Wohler**
 RR#, St. Address, Box # **G 2222** Board of Agriculture, Division of Water Resources
 City, State, ZIP Code: **Atchey Kans 66531** Application Number: **Riley Kans**

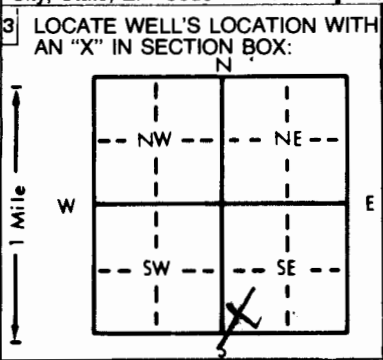

4 DEPTH OF COMPLETED WELL: **65** ft. ELEVATION: **greeny Kans**
 Depth(s) Groundwater Encountered 1. **51** ft. 2. **51** ft. 3. **51** ft.
 WELL'S STATIC WATER LEVEL: **40** ft. below land surface measured on mo/day/yr **3-1-1986**
 Pump test data: Well water was ft. after hours pumping gpm
 Est. Yield: **20** gpm: Well water was ft. after hours pumping gpm
 Bore Hole Diameter: **10** in. to **14** ft., and **6 1/2** in. to **6 5** ft.
 WELL WATER TO BE USED AS:
 1 Domestic 3 Feedlot 6 Oil field water supply 9 Dewatering 12 Other (Specify below)
 2 Irrigation 4 Industrial 7 Lawn and garden only 10 Observation well
 Was a chemical/bacteriological sample submitted to Department? Yes.....No ; If yes, mo/day/yr sample was submitted
 Water Well Disinfected? Yes No

5 TYPE OF BLANK CASING USED:
 1 Steel 3 RMP (SR) 5 Wrought iron 8 Concrete tile CASING JOINTS: Glued Clamped
 2 PVC 4 ABS 6 Asbestos-Cement 9 Other (specify below) Welded
 7 Fiberglass 10 Asbestos-cement Threaded
 Blank casing diameter: **5** in. to **4 0** ft., Dia. **5-30'** in. perforated **5'** plain lower end **all 5' dia'** in. to ft.
 Casing height above land surface: **1240** in., weight **200 P.S.I.** lbs./ft. Wall thickness or gauge No.
 TYPE OF SCREEN OR PERFORATION MATERIAL:
 1 Steel 3 Stainless steel 5 Fiberglass 7 PVC 10 Asbestos-cement
 2 Brass 4 Galvanized steel 6 Concrete tile 9 ABS 11 Other (specify)
 12 None used (open hole)
 SCREEN OR PERFORATION OPENINGS ARE:
 1 Continuous slot 3 Mill slot 5 Gauzed wrapped 8 Saw cut 11 None (open hole)
 2 Louvered shutter 4 Key punched 6 Wire wrapped 9 Drilled holes
 7 Torch cut 10 Other (specify)
 SCREEN-PERFORATED INTERVALS: From **4 0** ft. to **6 0** ft., From ft. to ft.
 From ft. to **1 8** ft., From ft. to ft.
 GRAVEL PACK INTERVALS: From **6 5** ft. to ft., From ft. to ft.
 From ft. to ft., From ft. to ft.

6 GROUT MATERIAL: 1 Neat cement 2 Cement grout 3 Bentonite 4 Other
 Grout Intervals: From ft. to ft., From **1 4** ft. to **4** ft., From ft. to ft.
 What is the nearest source of possible contamination:
 1 Septic tank 4 Lateral lines 7 Pit privy 10 Livestock pens 14 Abandoned water well
 2 Sewer lines 5 Cess pool 8 Sewage lagoon 11 Fuel storage 15 Oil well/Gas well
 3 Watertight sewer lines 6 Sewage pit 9 Feedyard 12 Fertilizer storage 16 Other (specify below)
 13 Insecticide storage
 Direction from well? **South** How many feet? **300**

FROM	TO	LITHOLOGIC LOG	FROM	TO	LITHOLOGIC LOG
0	6	Top soil, Black			
6	30	Clay, Red			
30	51	Limestone yellow Water at lower end 20 GPM			
51	60	Shale, Blue			
60	65	Rock, Hard Blue			

7 CONTRACTOR'S OR LANDOWNER'S CERTIFICATION: This water well was (1) constructed, (2) reconstructed, or (3) plugged under my jurisdiction and was completed on (mo/day/year) **March 12 1986** and this record is true to the best of my knowledge and belief. Kansas Water Well Contractor's License No. **237** This Water Well Record was completed on (mo/day/yr) **March 2nd-86** under the business name of **Strader Drilling Co** by signature **Harold Strader**

INSTRUCTIONS: Use typewriter or ball point pen, PLEASE PRESS FIRMLY and PRINT clearly. Please fill in blanks, underline or circle the correct answers. Send top three copies to Kansas Department of Health and Environment, Division of Environment, Environmental Geology Section, Topeka, KS 66620. Send one to WATER WELL OWNER and retain one for your records.

OFFICE USE ONLY T R EW SEC. 1/4 1/4 1/4