


1 LOCATION OF WATER WELL: County: **RILEY** Fraction: **SW 1/4 SW 1/4 SE 1/4** Section Number: **4** Township Number: **T 6 S** Range Number: **R 5 E 1/4**

Distance and direction from nearest town or city street address of well if located within city?  
**Barnes 10 mi South to Co line 1 mile West 1 mi South**  
 2 WATER WELL OWNER: **United Methodist Church** on east side of road  
 RR#, St. Address, Box #: **Ober Kans**  
 City, State, ZIP Code: **Phillis Wohler green Hans 66447** Application Number:

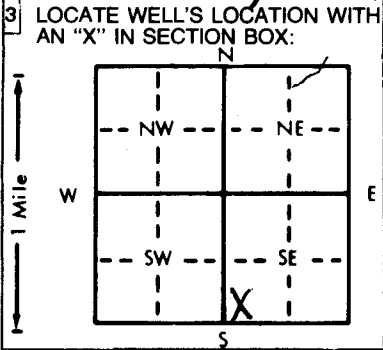

4 DEPTH OF COMPLETED WELL: **60** ft. ELEVATION:  
 Depth(s) Groundwater Encountered: **1. 41' - 50'** ft. 2. ft. 3. ft.  
 WELL'S STATIC WATER LEVEL: **41'** ft. below land surface measured on mo/day/yr **May 21-86**  
 Pump test data: Well water was ft. after hours pumping gpm  
 Est. Yield: **20** gpm; Well water was ft. after hours pumping gpm  
 Bore Hole Diameter: **10** in. to **3 8** ft., and **8 1/2** in. to **60** ft.  
 WELL WATER TO BE USED AS:  
 1 Domestic  3 Feedlot  6 Oil field water supply  9 Dewatering  12 Other (Specify below)  
 2 Irrigation  4 Industrial  7 Lawn and garden only  10 Observation well  
 Was a chemical/bacteriological sample submitted to Department? Yes No  X; If yes, mo/day/yr sample was submitted  
 Water Well Disinfected? Yes  X No

5 TYPE OF BLANK CASING USED:  
 1 Steel  3 RMP (SR)  5 Wrought iron  8 Concrete tile CASING JOINTS: Glued  X Clamped  
 2 PVC  4 ABS  6 Asbestos-Cement  9 Other (specify below) Welded  
 7 Fiberglass Threaded  
 Blank casing diameter: **5** in. to **40** ft., Dia. **5** in. to **60** screen ft., Dia. in. to ft.  
 Casing height above land surface: **12** in., weight: **200 PSI** lbs./ft. Wall thickness or gauge No.  
 TYPE OF SCREEN OR PERFORATION MATERIAL:  
 1 Steel  3 Stainless steel  5 Fiberglass  8 RMP (SR)  11 Other (specify)  
 2 Brass  4 Galvanized steel  6 Concrete tile  9 ABS  12 None used (open hole)  
 SCREEN OR PERFORATION OPENINGS ARE:  
 1 Continuous slot  3 Mill slot  5 Gauzed wrapped  8 Saw cut  11 None (open hole)  
 2 Louvered shutter  4 Key punched  6 Wire wrapped  9 Drilled holes  
 7 Torch cut  10 Other (specify)  
 SCREEN-PERFORATED INTERVALS: From **60** ft. to **40** ft., From ft. to ft.  
 GRAVEL PACK INTERVALS: From **60** ft. to **40** ft., From ft. to ft.

6 GROUT MATERIAL:  1 Neat cement  2 Cement grout  3 Bentonite  4 Other  
 Grout Intervals: From **40** ft. to **5** ft., From ft. to ft., From ft. to ft.  
 What is the nearest source of possible contamination:  
 1 Septic tank  4 Lateral lines  7 Pit privy  10 Livestock pens  14 Abandoned water well  
 2 Sewer lines  5 Cess pool  8 Sewage lagoon  11 Fuel storage  15 Oil well/Gas well  
 3 Watertight sewer lines  6 Seepage pit  9 Feedyard  12 Fertilizer storage  16 Other (specify below)  
 13 Insecticide storage  
 Direction from well? **Southwest** How many feet? **900'**

FROM	TO	LITHOLOGIC LOG	FROM	TO	LITHOLOGIC LOG
		top soil 0-3			
		clay 3-8			
		8-38 shale Red			
		38-50 limestone yellow			Water 41' to 50'
		50-60 shale Blue			

7 CONTRACTOR'S OR LANDOWNER'S CERTIFICATION: This water well was  (1) constructed,  (2) reconstructed, or  (3) plugged under my jurisdiction and was completed on (mo/day/year) **May 21-86** and this record is true to the best of my knowledge and belief. Kansas Water Well Contractor's License No. **2376** This Water Well Record was completed on (mo/day/yr) **May 26-86** under the business name of **Strader Drilling Co** by (signature) **Harold Strader**  
 INSTRUCTIONS: Use typewriter or ball point pen, PLEASE PRESS FIRMLY and PRINT clearly. Please fill in blanks, underline or circle the correct answers. Send top three copies to Kansas Department of Health and Environment, Division of Environment, Environmental Geology Section, Topeka, KS 66620. Send one to WATER WELL OWNER and retain one for your records.

OFFICE USE ONLY