


1 LOCATION OF WATER WELL: Fraction Section Number Township Number Range Number  
 County: **Riley** NE ¼ NE ¼ SE ¼ 9 T 6 S R 6 (NW)

Distance and direction from nearest town or city street address of well if located within city?  
**8 North of Randolph on HWY 77 GPS 39°32.86N 096°45.424W**

2 WATER WELL OWNER: **Jon Henry**  
 RR#, St. Address, Box # : **20949 Tuttle Creek Blvd** Board of Agriculture, Division of Water Resources  
 City, State, ZIP Code : **Randolph KS 66554** Application Number:

3 LOCATE WELL'S LOCATION WITH AN "X" IN SECTION BOX: 4 DEPTH OF COMPLETED WELL... **110** ft. ELEVATION: ..... ft.  
 Depth(s) Groundwater Encountered 1. .... ft. 2. .... ft. 3. .... ft.  
 WELL'S STATIC WATER LEVEL... **88** ft. below land surface measured on mo/day/yr **1/03/02** ft.  
 Pump test data: Well water was ..... ft. after ..... hours pumping ..... gpm  
 Est. Yield .... **15** gpm: Well water was ..... ft. after ..... hours pumping ..... gpm  
 Bore Hole Diameter... **8** in. to **11.2** ft., and ..... in. to ..... ft.  
 WELL WATER TO BE USED AS: 5 Public water supply 8 Air conditioning 11 Injection well  
 1 Domestic 3 Feedlot 6 Oil field water supply 9 Dewatering 12 Other (Specify below)  
 2 Irrigation 4 Industrial 7 Domestic (lawn & garden) 10 Monitoring well .....  
 Was a chemical/bacteriological sample submitted to Department? Yes. .... No. **\***; If yes, mo/day/yr sample was submitted  
 Water Well Disinfected? Yes **\*** No

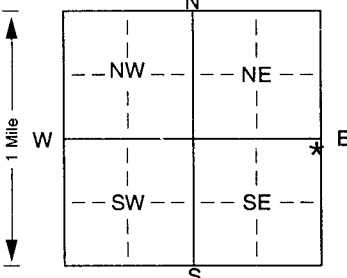

5 TYPE OF BLANK CASING USED: 5 Wrought iron 8 Concrete tile CASING JOINTS: Glued. **\*** Clamped. ....  
 1 Steel 3 RMP (SR) 6 Asbestos-Cement 9 Other (specify below) Welded .....  
 2 PVC 4 ABS 7 Fiberglass ..... Threaded. ....  
 Blank casing diameter .... **5** in. to **90** ft., Dia ..... in. to ..... ft., Dia ..... in. to ..... ft.  
 Casing height above land surface... **18** in., weight **200** lbs./ft. Wall thickness or gauge No. **265**  
 TYPE OF SCREEN OR PERFORATION MATERIAL: 7 PVC 10 Asbestos-cement  
 1 Steel 3 Stainless steel 5 Fiberglass 8 RMP (SR) 11 Other (specify) .....  
 2 Brass 4 Galvanized steel 6 Concrete tile 9 ABS 12 None used (open hole)  
 SCREEN OR PERFORATION OPENINGS ARE: 5 Gauzed wrapped 8 Saw cut 11 None (open hole)  
 1 Continuous slot 3 Mill slot 6 Wire wrapped 9 Drilled holes  
 2 Louvered shutter 4 Key punched 7 Torch cut 10 Other (specify) ..... ft.  
 SCREEN-PERFORATED INTERVALS: From... **90** ft. to **110** ft., From ..... ft. to ..... ft.  
 From ..... ft. to ..... ft., From ..... ft. to ..... ft.  
 GRAVEL PACK INTERVALS: From... **30** ft. to **110** ft., From ..... ft. to ..... ft.  
 From ..... ft. to ..... ft., From ..... ft. to ..... ft.

6 GROUT MATERIAL: 1 Neat cement 2 Cement grout 3 Bentonite 4 Other .....  
 Grout Intervals: From... **5** ft. to **30** ft., From ..... ft. to ..... ft., From ..... ft. to ..... ft.  
 What is the nearest source of possible contamination:  
 1 Septic tank 4 Lateral lines 7 Pit privy 10 Livestock pens 14 Abandoned water well  
 2 Sewer lines 5 Cess pool 8 Sewage lagoon 11 Fuel storage 15 Oil well/Gas well  
 3 Watertight sewer lines 6 Seepage pit 9 Feedyard 12 Fertilizer storage 16 Other (specify below)  
 13 Insecticide storage .....  
 Direction from well? **SE** How many feet? **150**

FROM	TO	LITHOLOGIC LOG	FROM	TO	PLUGGING INTERVALS
0	8	Brown Clay			
8	15	Tab Clay			
15	22	Limestone & Yellow Shale			
22	50	Yellow Shale			
50	60	Gray Shale			
60	64	Limestone			
64	81	Gray Shale			
81	101	Limestone			
101	104	Cavern			
104	107	Limestone			
107	112	Gray Shale			

7 CONTRACTOR'S OR LANDOWNER'S CERTIFICATION: This water well was (1) constructed, (2) reconstructed, or (3) plugged under my jurisdiction and was completed on (mo/day/year) .... **1/03/02** ..... and this record is true to the best of my knowledge and belief. Kansas Water Well Contractor's Licence No. .... **518** ..... This Water Well Record was completed on (mo/day/yr) **1/30/02** ..... under the business name of **Blue Valley Drilling** by (signature) *Eric Stuck*