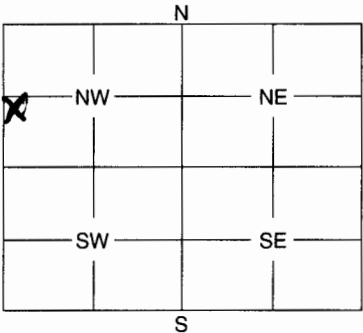


1 LOCATION OF WATER WELL: Fraction Section Number Township Number Range Number
 County: Riley NW 1/4 SW 1/4 NW 1/4 33 6 6 E/W

Distance and direction from nearest town or city street address of well if located within city?

2 WATER WELL OWNER: Mrs. Bernice Hagenmaier
 RR #, St. Address, Box #: 1773 N. Otter Branch Board of Agriculture, Division of Water Resources
 City, State, ZIP Code: Randolph, KS. 66554 Application Number: _____

3 MARK WELL'S LOCATION WITH AN "X" IN SECTION BOX:


4 DEPTH OF WELL 55 ft.
 WELL'S STATIC WATER LEVEL 15 ft.
 WELL WAS USED AS:
 1 Domestic 5 Public Water Supply 9 Dewatering
 2 Irrigation 6 Oil Field Water Supply 10 Monitoring Well
 3 Feedlot 7 Domestic (Lawn & Garden) 11 Injection Well
 4 Industrial 8 Air Conditioning 12 Other

Was a chemical / bacteriological sample submitted to Department? Yes No
 If yes, mo/day/yr sample was submitted

Water Well Disinfected: Yes No

5 TYPE OF BLANK CASING USED:
 1 Steel 3 RMP (SR) 5 Wrought 7 Fiberglass 9 Other (Specify below)
 2 PVC 4 ABS 6 Asbestos-Cement 8 Concrete Tile

Blank casing diameter 5 in. Was casing pulled? Yes No If yes, how much 3 feet
 Casing height above or below land surface 36 in.

6 GROUT PLUG MATERIAL: 1 Neat cement 2 Cement grout Bentonite 4 Other

Grout Plug Intervals: From 3 ft. to 55 ft., From _____ ft. to _____ ft., From _____ to _____ ft.

What is the nearest source of possible contamination:
 1 Septic tank 6 Seepage pit 11 Fuel storage 16 Other (specify below)
 2 Sewer lines 7 Pit privy 12 Fertilizer storage Contaminated well
 3 Watertight sewer lines 8 Sewage lagoon 13 Insecticide storage Contaminated with PCBs
 4 Lateral lines 9 Feedyard 14 Abandoned water well from submersible
 5 Cess pool 10 Livestock pens 15 Oil well/Gas well pump.

Direction from well? How many feet?

FROM	TO	PLUGGING MATERIALS
0	3	Soil
3	55	Bentonite (6.9 ft ³) 10 Bags

7 CONTRACTOR'S OF LANDOWNER'S CERTIFICATION: This water well was plugged under my jurisdiction and was completed on (mo/day/year) 4/22/2010 and this record is true to the best of my knowledge and belief. Kansas Water Well Contractor's License No. 760 This Water Well Record was completed on (mo/day/year) 6-10-2010 under the business name of Associated Drilling Inc by (signature) [Signature]

INSTRUCTIONS: Use typewriter or ball point pen. Please press firmly and print clearly. Please fill in blanks, underline or circle the correct answers. Send top three copies to Kansas Department of Health and Environment, Bureau of Water, Geology Section, 1000 SW Jackson St., Ste. 420, Topeka, Kansas 66612-1367. Telephone: 785/296-5522. Send one to Water Well Owner and retain one for your records.