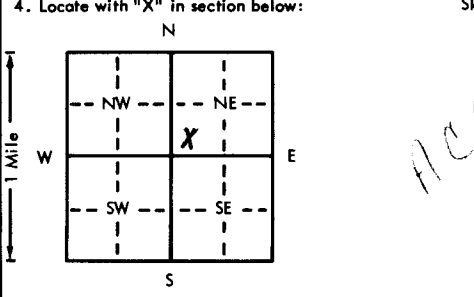


USE TYPEWRITER OR BALL POINT PEN-PRESS FIRMLY, PRINT CLEARLY

WATER WELL RECORD  
KSA 82a-1201-1215

Kansas Department of Health and Environment-Division of Environment  
(Water well Contractors)  
Topeka, Kansas 66620

1. Location of well: County <u>Riley</u> Fraction <u>SW 1/4 SW 1/4 NE 1/4</u> Section number <u>20</u> Township number T <u>6</u> S R <u>6</u> (EW)	
2. Distance and direction from nearest town or city: <u>5 1/2 N - 1 1/2 W</u> Street address of well location if in city: <u>OF Randolph Ks.</u> 3. Owner of well: <u>Eldon Rolfs</u> R.R. or street: <u>R.R.</u> City, state, zip code: <u>Randolph Ks</u>	
4. Locate with "X" in section below: Sketch map: 	
6. Bore hole dia. <u>8</u> in. Completion date <u>4-3-76</u> Well depth <u>54</u> ft.	
7. <input checked="" type="checkbox"/> Cable tool <input type="checkbox"/> Rotary <input type="checkbox"/> Driven <input type="checkbox"/> Dug <input type="checkbox"/> Hollow rod <input type="checkbox"/> Jetted <input type="checkbox"/> Bored <input type="checkbox"/> Reverse rotary	
8. Use: <input checked="" type="checkbox"/> Domestic <input type="checkbox"/> Public supply <input type="checkbox"/> Industry <input type="checkbox"/> Irrigation <input type="checkbox"/> Air conditioning <input type="checkbox"/> Stock <input type="checkbox"/> Lawn <input type="checkbox"/> Oil field water <input type="checkbox"/> Other	
9. Casing: Material <u>PVC</u> Height: Above or below Threaded <input type="checkbox"/> Welded <u>GI</u> Surface <u>18</u> in. RMP <input type="checkbox"/> PVC <input checked="" type="checkbox"/> Weight <u>4.4</u> lbs./ft. Dia. <u>5</u> in. to <u>54</u> ft. depth Wall Thickness: inches or Dia. <u>5</u> in. to <u>54</u> ft. depth gage No. <u>258</u>	
10. Screen: Manufacturer's name <u>Jess Howell Casing Co.</u> Type <u>PVC</u> Dia. <u>5 1/4</u> Slot/gauze <u>4/16</u> Length <u>30'</u> Set between <u>4 1/4</u> ft. and <u>54</u> ft. Gravel pack? <u>yes</u> Size range of material <u>4-8</u>	
11. Type and color of material From To <u>Calumet Old Hole and Recase 54 feet deep</u> <u>Drill Black</u> ? 10 54	
12. Pumping level below land surfaces: <u>20</u> ft. below land surface Date <u>4-3-76</u> mo./day/yr.	
13. Water sample submitted: <u>Yes</u> <input checked="" type="checkbox"/> No <input type="checkbox"/> Date	
14. Well head completion: <u>18</u> Pitless adapter <u>18</u> inches above grade	
15. Well grouted? <u>yes</u> With: <input checked="" type="checkbox"/> Neat cement <input type="checkbox"/> Bentonite <input type="checkbox"/> Concrete Depth: From <u>0</u> ft. to <u>10</u> ft.	
16. Nearest source of possible contamination: <u>100</u> ft. Direction <u>SW</u> Type <u>Septic Tank</u> Well disinfected upon completion? <input checked="" type="checkbox"/> Yes <input type="checkbox"/> No	
17. Pump: <input checked="" type="checkbox"/> Not installed Manufacturer's name _____ HP _____ Volts _____ Length of drop pipe _____ ft. capacity _____ g.p.m. Type: <input type="checkbox"/> Submersible <input type="checkbox"/> Turbine <input type="checkbox"/> Jet <input type="checkbox"/> Reciprocating <input type="checkbox"/> Centrifugal <input type="checkbox"/> Other	
(Use a second sheet if needed)	
18. Elevation: Topography: <input type="checkbox"/> Hill <input type="checkbox"/> Slope <input type="checkbox"/> Upland <input checked="" type="checkbox"/> Valley	19. Remarks: <u>Concrete slab to be poured by land owner</u> <u>Eldon J. Rolfs</u>
20. Water well contractor's certification: This well was drilled under my jurisdiction and this report is true to the best of my knowledge and belief. <u>Harper</u> Business name <u>196</u> License No. Address <u>B.R. 76</u> Signed <u>T. B. Harper</u> Date <u>4-3-76</u> Authorized representative	

T  
R  
W  
Sec  
20  
SUS  
1/4  
1/4  
1/4

Forward the white, blue and pink copies to the Department of Health and Environment

Form WWC-5