


1 LOCATION OF WATER WELL: County: Riley	Fraction SE 1/4 SW 1/4 SE 1/4	Section Number 17	Township Number T 6-7-S	Range Number R 6-7-E/W
---	---	-----------------------------	-----------------------------------	----------------------------------

Distance and direction from nearest town or city street address of well if located within city?
1/2 North, 3/4 West of Randolph

2 WATER WELL OWNER: **David & Marcy Uphoff**
 RR#, St. Address, Box # : **10240 Green/Randolph Rd.**
 City, State, ZIP Code : **Randolph, KS. 66554**

Board of Agriculture, Division of Water Resources
Application Number:

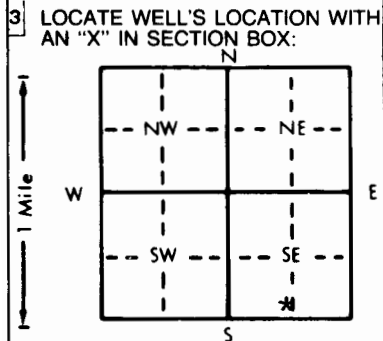

4 DEPTH OF COMPLETED WELL: **60** ft. ELEVATION: _____ ft.

Depth(s) Groundwater Encountered 1. _____ ft. 2. _____ ft. 3. _____ ft.

WELL'S STATIC WATER LEVEL: **15** ft. below land surface measured on mo/day/yr **6/20/98**

Pump test data: Well water was _____ ft. after _____ hours pumping _____ gpm

Est. Yield **12** gpm: Well water was _____ ft. after _____ hours pumping _____ gpm

Bore Hole Diameter: **9"** in. to **62** ft., and _____ in. to _____ ft.

WELL WATER TO BE USED AS:

5 Public water supply	8 Air conditioning	11 Injection well
1 Domestic	3 Feedlot	6 Oil field water supply
2 Irrigation	4 Industrial	7 Lawn and garden only
		10 Monitoring well
		12 Other (Specify below)

Was a chemical/bacteriological sample submitted to Department? Yes _____ No ***** _____; If yes, mo/day/yr sample was submitted _____

Water Well Disinfected? Yes ***** _____ No _____

5 TYPE OF BLANK CASING USED:

1 Steel	3 RMP (SR)	5 Wrought iron	8 Concrete tile	CASING JOINTS: Glued * _____ Clamped _____
2 PVC	4 ABS	6 Asbestos-Cement	9 Other (specify below)	Welded _____
		7 Fiberglass		Threaded _____

Blank casing diameter: **5** in. to **20** ft., Dia _____ in. to _____ ft., Dia _____ in. to _____ ft.

Casing height above land surface: **24** in., weight **200** lbs./ft. Wall thickness or gauge No. **265**

TYPE OF SCREEN OR PERFORATION MATERIAL:

1 Steel	3 Stainless steel	5 Fiberglass	8 RMP (SR)	10 Asbestos-cement
2 Brass	4 Galvanized steel	6 Concrete tile	9 ABS	11 Other (specify) _____
				12 None used (open hole)

SCREEN OR PERFORATION OPENINGS ARE:

1 Continuous slot	3 Mill slot	5 Gauzed wrapped	8 Saw cut	11 None (open hole)
2 Louvered shutter	4 Key punched	6 Wire wrapped	9 Drilled holes	
		7 Torch cut	10 Other (specify) _____	

SCREEN-PERFORATED INTERVALS: From **20** ft. to **40** ft., From _____ ft. to _____ ft., From _____ ft. to _____ ft.

GRAVEL PACK INTERVALS: From **20** ft. to **60** ft., From _____ ft. to _____ ft., From _____ ft. to _____ ft.

6 GROUT MATERIAL: 1 Neat cement 2 Cement grout 3 Bentonite 4 Other _____

Grout Intervals: From **5** ft. to **20** ft., From _____ ft. to _____ ft., From _____ ft. to _____ ft.

What is the nearest source of possible contamination:

1 Septic tank	4 Lateral lines	7 Pit privy	10 Livestock pens	14 Abandoned water well
2 Sewer lines	5 Cess pool	8 Sewage lagoon	11 Fuel storage	15 Oil well/Gas well
3 Watertight sewer lines	6 Seepage pit	9 Feedyard	12 Fertilizer storage	16 Other (specify below)
			13 Insecticide storage	

Direction from well? **SW** How many feet? **500**

FROM	TO	LITHOLOGIC LOG	FROM	TO	PLUGGING INTERVALS
0	7	Brown Clay			
7	14	Limestone			
14	16	Tan Shale			
16	19	Red Shale			
19	21	Tan Shale			
21	24	Yellow Shale & Limestone			
24	34	Gray Shale			
34	38	Gray Limestone			
38	62	Gray Shale			

7 CONTRACTOR'S OR LANDOWNER'S CERTIFICATION: This water well was (1) constructed, (2) reconstructed, or (3) plugged under my jurisdiction and was completed on (mo/day/year) **6/20/98** and this record is true to the best of my knowledge and belief. Kansas Water Well Contractor's License No. **518** This Water Well Record was completed on (mo/day/yr) **6/21/98** under the business name of **Blue Valley Drilling** by (signature) _____