


1 LOCATION OF WATER WELL: County: POTAWATOMIE Fraction: SE 1/4 SW 1/4 SE 1/4 Section Number: 22 Township Number: T 6 S Range Number: R 7 E
 Distance and direction from nearest town or city street address of well if located within city? From Olsburg Go East To First County Road To North Turn Go 5 1/2 Miles North West

2 WATER WELL OWNER: Pott Co RWD #2
 RR#, St. Address, Box #: RR Board of Agriculture, Division of Water Resources
 City, State, ZIP Code: Olsburg, Kansas 66520 Application Number:

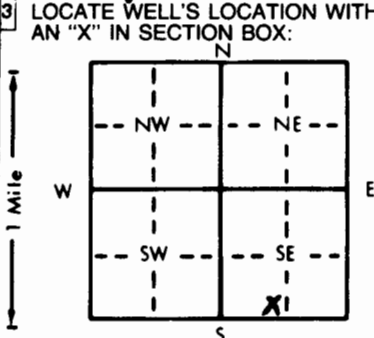

4 DEPTH OF COMPLETED WELL: 100' ft. ELEVATION:
 Depth(s) Groundwater Encountered 1. 40' ft. 2. ft. 3. ft.
 WELL'S STATIC WATER LEVEL: 40' ft. below land surface measured on mo/day/yr
 Pump test data: Well water was ft. after hours pumping gpm
 Est. Yield 500 gpm: Well water was ft. after hours pumping gpm
 Bore Hole Diameter: 6" in. to 100' ft., and in. to ft.
 WELL WATER TO BE USED AS:
 1 Domestic 3 Feedlot 5 Public water supply 8 Air conditioning 11 Injection well
 2 Irrigation 4 Industrial 6 Off field water supply 9 Dewatering 12 Other (Specify below)
 7 Lawn and garden only 10 Monitoring well
 Was a chemical/bacteriological sample submitted to Department? Yes.....No.....; If yes, mo/day/yr sample was submitted Water Well Disinfected? Yes No

5 TYPE OF BLANK CASING USED:
 1 Steel 3 RMP (SR) 5 Wrought iron 8 Concrete tile CASING JOINTS: Glued.....Clamped.....
 2 PVC 4 ABS 6 Asbestos-Cement 9 Other (specify below) Welded.....
 7 Fiberglass Threaded.....
 Blank casing diameter: 2 1/2 in. to 70' ft., Dia. in. to ft., Dia. in. to ft.
 Casing height above land surface: 16" in., weight Sch 40 lbs./ft. Wall thickness or gauge No.
 TYPE OF SCREEN OR PERFORATION MATERIAL:
 1 Steel 3 Stainless steel 5 Fiberglass 7 PVC 10 Asbestos-cement
 2 Brass 4 Galvanized steel 6 Concrete tile 8 RMP (SR) 11 Other (specify)
 12 None used (open hole)
 SCREEN OR PERFORATION OPENINGS ARE:
 1 Continuous slot 3 Mill slot 5 Gauzed wrapped 7 Saw cut 11 None (open hole)
 2 Louvered shutter 4 Key punched 6 Wire wrapped 9 Drilled holes
 7 Torch cut 10 Other (specify)
 SCREEN-PERFORATED INTERVALS: From 70 ft. to 90 ft., From ft. to ft.
 GRAVEL PACK INTERVALS: From 20 ft. to 100 ft., From ft. to ft.

6 GROUT MATERIAL: 1 Neat cement 2 Cement grout 3 Bentonite 4 Other
 Grout Intervals: From 0 ft. to 20 ft., From ft. to ft., From ft. to ft.
 What is the nearest source of possible contamination:
 1 Septic tank 4 Lateral lines None, Close 7 Pit privy 10 Livestock pens 14 Abandoned water well
 2 Sewer lines 5 Cess pool 8 Sewage lagoon 11 Fuel storage 15 Oil well/Gas well
 3 Watertight sewer lines 6 Seepage pit 9 Feedyard 12 Fertilizer storage 16 Other (specify below)
 13 Insecticide storage

Direction from well? How many feet?

| FROM | TO | LITHOLOGIC LOG | FROM | TO | PLUGGING INTERVALS |
|------|-----|----------------------------|------|----|--------------------|
| 0 | 11 | Brown Clay | | | |
| 11 | 24 | Sandy Clay | | | |
| 24 | 39 | Gravel + L. Silt Mixed | | | |
| 39 | 48 | Gravel + More Silt | | | |
| 48 | 50 | Limestone | | | |
| 50 | 60 | Gravel, Medium Sand + Silt | | | |
| 60 | 70 | Gravel + Medium Sand | | | |
| 70 | 98 | Coarse Sand + Fine Gravel | | | |
| 98 | 100 | Shale | | | |

TEST Hole with 2" casing

7 CONTRACTOR'S OR LANDOWNER'S CERTIFICATION: This water well was (1) constructed (2) reconstructed, or (3) plugged under my jurisdiction and was completed on (mo/day/year) 1/18/91 and this record is true to the best of my knowledge and belief. Kansas Water Well Contractor's License No. 451 This Water Well Record was completed on (mo/day/yr) 2/14/91 under the business name of Haldeman Well Drilling by (signature) Craig W. CWD/PE