


USE TYPEWRITER OR BALL POINT PEN-PRESS FIRMLY, PRINT CLEARLY.

WATER WELL RECORD
KSA 82a-1201-1215

Kansas Department of Health and Environment-Division of Environment
(Water well Contractors)
Topeka, Kansas 66620

1. Location of well:	County Pott	Fraction SE 1/4 SW 1/4 SE 1/4	Section number 35	Township number T 6 S R 8	Range number 8	EAN
----------------------	--------------------	--------------------------------------	--------------------------	----------------------------------	-----------------------	-----

2. Distance and direction from nearest town or city: Street address of well location in city:	2 NE-1 1/2 W - 1/2 W of Fostoria KS	3. Owner of well: R.R. number : City, state, zip code:	James Crothers 1 Westmorland Kan 66549
--	--	---	---

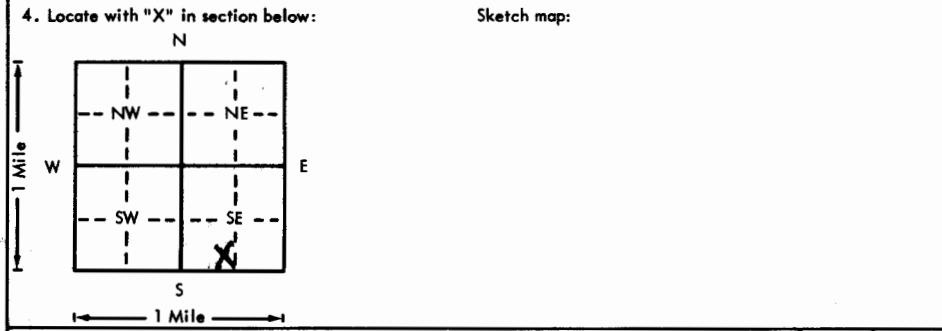

6. Bore hole dia. 8 in. Completion date 5-28-77 Well depth 77 ft.
7. <input checked="" type="checkbox"/> Cable tool <input type="checkbox"/> Rotary <input type="checkbox"/> Driven <input type="checkbox"/> Dug <input type="checkbox"/> Hollow rod <input type="checkbox"/> Jetted <input type="checkbox"/> Bored <input type="checkbox"/> Reverse rotary
8. Use: <input checked="" type="checkbox"/> Domestic <input type="checkbox"/> Public supply <input type="checkbox"/> Industry <input type="checkbox"/> Irrigation <input type="checkbox"/> Air conditioning <input type="checkbox"/> Stock <input type="checkbox"/> Lawn <input type="checkbox"/> Oil field water <input type="checkbox"/> Other
9. Casing: Material PVC Height: Above or below Threaded <input type="checkbox"/> Welded Flue Surface 30 in. RMP <input type="checkbox"/> PVC <input checked="" type="checkbox"/> Weight <input type="checkbox"/> lbs./ft. Dia. 5 in. to 77 ft. depth Wall Thickness: inches or Dia. <input type="checkbox"/> in. to <input type="checkbox"/> ft. depth Gage No. Sch 40

5. Type and color of material	From	To
Clay Brown	0	5
Lime Rocks	5	10
Clay Yellow	10	15
Lime Rock White	15	20
Clay Blue	20	30
Shale "	30	35
" "	35	40
Lime Rock Gray	40	45
Shale Brown	45	50
Clay White	50	60
Lime Rock Yellow	60	75
Shale Blue and Hard.	75	77
(Use a second sheet if needed)		

10. Screen: Manufacturer's name PUMPLE Type PVC Dia. 5" Slot/gauze 1/8 40 Length 30' Set between 1/8 40 ft. and 77 ft. Gravel pack? Yes Size range of material 1/8-1/4
11. Static water level: 40 ft. below land surface Date 5-28-77 mo./day/yr.
12. Pumping level below land surfaces: ____ ft. after ____ hrs. pumping ____ g.p.m. ____ ft. after ____ hrs. pumping ____ g.p.m. Estimated maximum yield ____ g.p.m.
13. Water sample submitted: X Yes <input type="checkbox"/> No Date ____
14. Well head completion: X Pitless adapter ____ inches above grade
15. Well grouted? Yes With: <input checked="" type="checkbox"/> Neat cement <input type="checkbox"/> Bentonite <input type="checkbox"/> Concrete Depth: From 5 ft. to 12 ft.
16. Nearest source of possible contamination: Septic Tank ft. 75' Direction S Type Tank Well disinfected upon completion? <input checked="" type="checkbox"/> Yes <input type="checkbox"/> No
17. Pump: <input checked="" type="checkbox"/> Not installed Manufacturer's name ____ Model number ____ HP ____ Volts ____ Length of drop pipe ____ ft. capacity ____ g.p.m. Type: <input type="checkbox"/> Submersible <input type="checkbox"/> Turbine <input type="checkbox"/> Jet <input type="checkbox"/> Reciprocating <input type="checkbox"/> Centrifugal <input type="checkbox"/> Other

18. Elevation:	19. Remarks: Cement slat to be poured by land owner James Crothers
----------------	--

20. Water well contractor's certification: This well was drilled under my jurisdiction and this report is true to the best of my knowledge and belief. Harper Delgerie 176 Business name License No. Address Blue Rapids, Kan. Signed Harper Delgerie Date 5-28-77 Authorized representative
--

Forward the white, blue and pink copies to the Department of Health and Environment

Form WWC-3

T 6 S R 8
SE 1/4
SW 1/4
NW 1/4
NE 1/4