


1 LOCATION OF WATER WELL: Fraction NW 1/4 SE 1/4 SE 1/4 Section Number 29 Township Number T 6 S Range Number R 9 E/W
 County: POTTAWATOMIE

Distance and direction from nearest town or city street address of well if located within city?
 1 1/4 west of Blaine

2 WATER WELL OWNER: Ron Taylor
 RR#, St. Address, Box #: Rt. 3 Box 43A Board of Agriculture, Division of Water Resources
 City, State, ZIP Code: Blaine, KS 66549 Application Number:

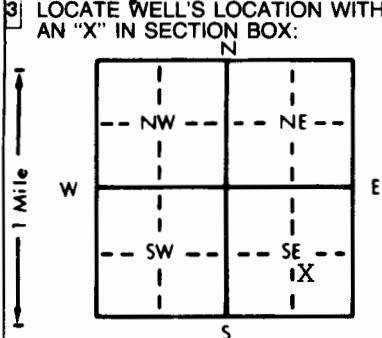

4 DEPTH OF COMPLETED WELL... 80' ft. ELEVATION: ...
 Depth(s) Groundwater Encountered 1... 47' ft. 2... ft. 3... ft.
 WELL'S STATIC WATER LEVEL... 42' ft. below land surface measured on mo/day/yr 3-01-91
 Pump test data: Well water was ... ft. after ... hours pumping ... gpm
 Est. Yield ... 3 ... gpm: Well water was ... ft. after ... hours pumping ... gpm
 Bore Hole Diameter... 8 3/4 in. to ... ft., and ... in. to ... ft.
 WELL WATER TO BE USED AS: 5 Public water supply 8 Air conditioning 11 Injection well
 1 Domestic 3 Feedlot 6 Oil field water supply 9 Dewatering 12 Other (Specify below)
 2 Irrigation 4 Industrial 7 Lawn and garden only 10 Monitoring well
 Was a chemical/bacteriological sample submitted to Department? Yes... No... X...; If yes, mo/day/yr sample was submitted
 Water Well Disinfected? Yes X No

5 TYPE OF BLANK CASING USED:
 1 Steel 3 RMP (SR) 5 Wrought iron 8 Concrete tile CASING JOINTS: Glued X Clamped
 2 PVC 4 ABS 6 Asbestos-Cement 9 Other (specify below) Welded
 7 Fiberglass Threaded
 Blank casing diameter ... 5" in. to ... 0-40 ... ft., Dia ... 5" in. to ... 60-80 ... ft., Dia ... in. to ... ft.
 Casing height above land surface... 24" in., weight ... 2.82 ... lbs./ft. Wall thickness or gauge No. ... 258
 TYPE OF SCREEN OR PERFORATION MATERIAL:) 7 PVC 10 Asbestos-cement
 1 Steel 3 Stainless steel 5 Fiberglass 8 RMP (SR) 11 Other (specify)
 2 Brass 4 Galvanized steel 6 Concrete tile 9 ABS 12 None used (open hole)
 SCREEN OR PERFORATION OPENINGS ARE:
 1 Continuous slot 3 Mill slot 5 Gauzed wrapped 8 Saw cut 11 None (open hole)
 2 Louvered shutter 4 Key punched 6 Wire wrapped 9 Drilled holes
 7 Torch cut 10 Other (specify)
 SCREEN-PERFORATED INTERVALS: From ... 40 ... ft. to ... 60 ... ft., From ... ft. to ... ft.
 GRAVEL PACK INTERVALS: From ... 24 ... ft. to ... 80 ... ft., From ... ft. to ... ft.

6 GROUT MATERIAL: 1 Neat cement 2 Cement grout 3 Bentonite 4 Other hole plug
 Grout Intervals: From ... 4 ... ft. to ... 24 ... ft., From ... ft. to ... ft., From ... ft. to ... ft.
 What is the nearest source of possible contamination:
 1 Septic tank 4 Lateral lines 7 Pit privy 10 Livestock pens 14 Abandoned water well
 2 Sewer lines 5 Cess pool 8 Sewage lagoon 11 Fuel storage 15 Oil well/Gas well
 3 Watertight sewer lines 6 Seepage pit 9 Feedyard 12 Fertilizer storage 16 Other (specify below)
 13 Insecticide storage
 Direction from well? south How many feet? 165'

FROM	TO	LITHOLOGIC LOG	FROM	TO	PLUGGING INTERVALS
0	11	Clay-Brown	73	76	Shale-Grey
11	13	Chert 1/2x1/2	76	80	Limestone-Grey
13	18	Shale-Grey			
18	26	Limestone-Yellow			
26	27	Shale-Yellow			
27	28	Limestone-Yellow			
28	32	Shale-Yellow			
32	41	Shale-Red			
41	44	Shale-Yellow			
44	47	Limestone-Yellow-Loose 3 GPM			
47	57	Shale-Grey			
57	64	Shale-Red			
64	65	Shale-Grey			
65	66	Limestone-Yellow			
66	73	Limestone-Grey			

7 CONTRACTOR'S OR LANDOWNER'S CERTIFICATION: This water well was (1) constructed, (2) reconstructed, or (3) plugged under my jurisdiction and was completed on (mo/day/year) ... 3-01-91 and this record is true to the best of my knowledge and belief. Kansas Water Well Contractor's License No. ... 182. This Water Well Record was completed on (mo/day/yr) 3-27-91 under the business name of STRADER DRILLING CO., INC. by (signature) Dalisoren