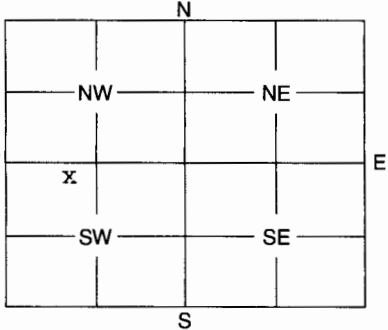


1	LOCATION OF WATER WELL: County: Pottawatomie	Fraction NE $\frac{1}{4}$ NW $\frac{1}{4}$ SW $\frac{1}{4}$	Section Number 27	Township Number 06	Range Number 09	E/W
---	--	--	-----------------------------	------------------------------	---------------------------	-----

Distance and direction from nearest town or city street address of well if located within city?
13315 Hwy 16, Blaine, KS 66549 (lot 4 Butler townsite original)

2	WATER WELL OWNER: RR #, St. Address, Box #: City, State, ZIP Code :	Roman Catholic Archdiocese of Kansas City Kansas 12615 Parallel Parkway Kansas City, KS 66109	Board of Agriculture, Division of Water Resources Application Number:
---	---	--	--

3	MARK WELL'S LOCATION WITH AN "X" IN SECTION BOX: 	4	DEPTH OF WELL 87' ft. WELL'S STATIC WATER LEVEL 55' ft. WELL WAS USED AS: <input checked="" type="radio"/> 1 Domestic <input type="radio"/> 2 Irrigation <input type="radio"/> 3 Feedlot <input type="radio"/> 4 Industrial <input type="radio"/> 5 Public Water Supply <input type="radio"/> 6 Oil Field Water Supply <input type="radio"/> 7 Domestic (Lawn & Garden) <input type="radio"/> 8 Air Conditioning <input type="radio"/> 9 Dewatering <input type="radio"/> 10 Monitoring Well <input type="radio"/> 11 Injection Well <input type="radio"/> 12 Other Was a chemical / bacteriological sample submitted to Department? Yes No <input checked="" type="checkbox"/> If yes, mo/day/yr sample was submitted Water Well Disinfected: Yes <input checked="" type="checkbox"/> No
---	---	---	--

5	TYPE OF BLANK CASING USED: <input checked="" type="radio"/> 1 Steel <input type="radio"/> 2 PVC <input type="radio"/> 3 RMP (SR) <input type="radio"/> 4 ABS <input type="radio"/> 5 Wrought <input type="radio"/> 6 Asbestos-Cement <input type="radio"/> 7 Fiberglass <input type="radio"/> 8 Concrete Tile <input type="radio"/> 9 Other (Specify below)	Blank casing diameter 5" in. Casing height above or below land surface 14' in.	Was casing pulled? Yes <input checked="" type="checkbox"/> No If yes, how much 6'
---	--	---	---

6	GROUT PLUG MATERIAL: Grout Plug Intervals: From 87' ft. to 9' ft., From 9' ft. to 7.5' ft., From 7.5' to +1' ft.	<input checked="" type="radio"/> 1 Neat cement <input type="radio"/> 2 Cement grout <input checked="" type="radio"/> 3 Bentonite <input type="radio"/> 4 Other	11 Fuel storage 12 Fertilizer storage 13 Insecticide storage 14 Abandoned water well 15 Oil well/Gas well 16 Other (specify below)
What is the nearest source of possible contamination: <input type="radio"/> 1 Septic tank <input type="radio"/> 2 Sewer lines <input type="radio"/> 3 Watertight sewer lines <input type="radio"/> 4 Lateral lines <input type="radio"/> 5 Cess pool <input type="radio"/> 6 Seepage pit <input type="radio"/> 7 Pit privy <input checked="" type="radio"/> 8 Sewage lagoon <input type="radio"/> 9 Feedyard <input type="radio"/> 10 Livestock pens			
Direction from well? NE		How many feet? 150'	

FROM	TO	PLUGGING MATERIALS
87'	9'	Chlorinated Sand
9'	7.5'	Bentonite
7.5'	+1'	Clean soil

7	CONTRACTOR'S OF LANDOWNER'S CERTIFICATION: This water well was plugged under my jurisdiction and was completed on (mo/day/year) 11/12/2014 and this record is true to the best of my knowledge and belief. Kansas Water Well Contractor's License No. This Water Well Record was completed on (mo/day/year) 11/12/2014 under the business name of Pottawatomie County Environmental Health by (signature) Scott Schwinn, R.S.
---	--

INSTRUCTIONS: Use typewriter or ball point pen. Please press firmly and print clearly. Please fill in blanks, underline or circle the correct answers. Send top three copies to Kansas Department of Health and Environment, Bureau of Water, Geology Section, 1000 SW Jackson St., Ste. 420, Topeka, Kansas 66612-1367. Telephone: 785/296-5522. Send one to Water Well Owner and retain one for your records.