


3-16-17

1	LOCATION OF WATER WELL: County: <b>Pottawatomie</b>	Fraction <b>NE NE NW NE</b> ¼ ¼ ¼	Section Number <b>3</b>	Township Number <b>T-7-S</b>	Range Number <b>R-10-E</b> E/W
---	--	---	----------------------------	---------------------------------	-----------------------------------

Distance and direction from nearest town or city street address of well if located within city?  
**Hwy 16 + Fremont Rd ¼ mile west of Fremont Rd on south side of K16 Hwy**

2	WATER WELL OWNER: <b>On KDOT Rightway</b>	RR #, St. Address, Box #: _____ City, State, ZIP Code : _____	Board of Agriculture, Division of Water Resources Application Number: _____
---	---	--	--

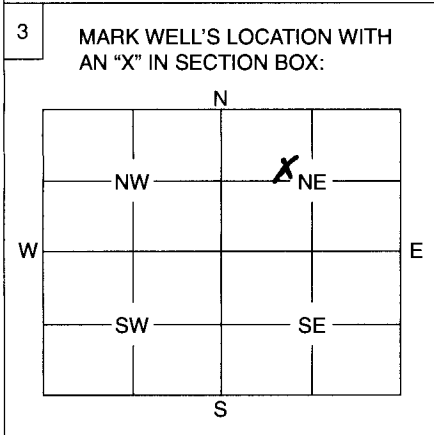

4 DEPTH OF WELL **10'** ft.  
WELL'S STATIC WATER LEVEL **Dry** ft.  
WELL WAS USED AS:  
 1 Domestic      5 Public Water Supply      9 Dewatering  
 2 Irrigation      6 Oil Field Water Supply      10 Monitoring Well  
 3 Feedlot      7 Domestic (Lawn & Garden)      11 Injection Well  
 4 Industrial      8 Air Conditioning      12 Other .....

Was a chemical / bacteriological sample submitted to Department? Yes ..... No **X**.....  
 If yes, mo/day/yr sample was submitted .....

Water Well Disinfected: Yes ..... No **X**.....

5 TYPE OF BLANK CASING USED:

1 Steel	3 RMP (SR)	5 Wrought	7 Fiberglass	9 Other (Specify below) <b>Hand dug - rock lined</b>
2 PVC	4 ABS	6 Asbestos-Cement	8 Concrete Tile	

Blank casing diameter ..... in.      Was casing pulled? Yes ..... No .....      If yes, how much .....

Casing height above or below land surface ..... in.

6 GROUT PLUG MATERIAL:      1 Neat cement      2 Cement grout      **3 Bentonite**      4 Other .....

Grout Plug Intervals:      From **-5** ft. to **-4.5** ft.,      From ..... ft. to ..... ft.,      From ..... to ..... ft.

What is the nearest source of possible contamination:

1 Septic tank	6 Seepage pit	11 Fuel storage	16 Other (specify below) <b>Highway Rightway</b>
2 Sewer lines	7 Pit privy	12 Fertilizer storage	
3 Watertight sewer lines	8 Sewage lagoon	13 Insecticide storage	
4 Lateral lines	9 Feedyard	14 Abandoned water well	
5 Cess pool	10 Livestock pens	15 Oil well/Gas well	

Direction from well? .....      How many feet? .....

FROM	TO	PLUGGING MATERIALS
		<b>28 bags of Bentonite</b>
		<b>dirt to ground level</b>
		<b>18" mound above that of dirt</b>

Latitude  
**39.4783 22**

Longitude  
**-96.2822 77**

7 CONTRACTOR'S OF LANDOWNER'S CERTIFICATION: This water well was plugged under my jurisdiction and was completed on (mo/day/year) **3-16-17** and this record is true to the best of my knowledge and belief. Kansas Water Well Contractor's License No. \_\_\_\_\_ This Water Well Record was completed on (mo/day/year) **3-16-17** under the business name of **Blaine KDOT Shop** by (signature) **Patrick J. Farnan HNS**

INSTRUCTIONS: Use typewriter or ball point pen. Please press firmly and print clearly. Please fill in blanks, underline or circle the correct answers. Send top three copies to Kansas Department of Health and Environment, Bureau of Water, Geology Section, 1000 SW Jackson St., Ste. 420, Topeka, Kansas 66612-1367. Telephone: 785/296-5522. Send one to Water Well Owner and retain one for your records.