


1 LOCATION OF WATER WELL: County: Pottawatomie Fraction: NE 1/4 SW 1/4 NE 1/4 Section Number: 34 Township Number: T 7 S Range Number: R 11 E/W

Distance and direction from nearest town or city street address of well if located within city?

201 Leonard, Onaga, KS

2 WATER WELL OWNER: Onaga Oil Company RR#, St. Address, Box #: 201 Leonard City, State, ZIP Code: Onaga, KS 66521 Board of Agriculture, Division of Water Resources Application Number: — Attn: K. Falk

3 LOCATE WELL'S LOCATION WITH AN "X" IN SECTION BOX: 4 DEPTH OF COMPLETED WELL: 15 ft. ELEVATION: —

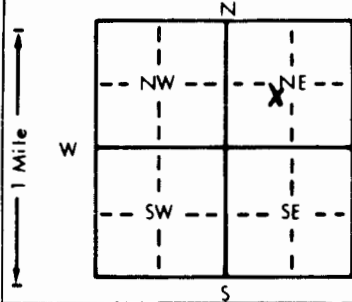

Depth(s) Groundwater Encountered 1. 7.0 ft. 2. — ft. 3. — ft.

WELL'S STATIC WATER LEVEL 4.0 ft. below land surface measured on mo/day/yr

Pump test data: Well water was — ft. after — hours pumping — gpm

Est. Yield — gpm: Well water was — ft. after — hours pumping — gpm

Bore Hole Diameter: 8.625 in. to — ft., and — in. to — ft.

WELL WATER TO BE USED AS: 5 Public water supply 8 Air conditioning 11 Injection well

1 Domestic 3 Feedlot 6 Oil field water supply 9 Dewatering 12 Other (Specify below)

2 Irrigation 4 Industrial 7 Lawn and garden only 10 Monitoring well m.w.-3

Was a chemical/bacteriological sample submitted to Department? Yes — No X; If yes, mo/day/yr sample was submitted

Water Well Disinfected? Yes — No X

5 TYPE OF BLANK CASING USED: 5 Wrought iron 8 Concrete tile CASING JOINTS: Glued — Clamped —

1 Steel 3 RMP (SR) 6 Asbestos-Cement 9 Other (specify below) Welded —

2 PVC 4 ABS 7 Fiberglass Threaded X

Blank casing diameter 2 1/2 in. to 5 ft. Dia. — in. to — ft. Dia. — in. to — ft.

Casing height above land surface 0 in., weight Schedule 40 lbs./ft. Wall thickness or gauge No. —

TYPE OF SCREEN OR PERFORATION MATERIAL: 7 PVC 10 Asbestos-cement

1 Steel 3 Stainless steel 5 Fiberglass 8 RMP (SR) 11 Other (specify) —

2 Brass 4 Galvanized steel 6 Concrete tile 9 ABS 12 None used (open hole)

SCREEN OR PERFORATION OPENINGS ARE: 5 Gauzed wrapped 8 Saw cut 11 None (open hole)

1 Continuous slot 3 Mill slot 6 Wire wrapped 9 Drilled holes

2 Louvered shutter 4 Key punched 7 Torch cut 10 Other (specify) —

SCREEN-PERFORATED INTERVALS: From 5 ft. to 15 ft. From — ft. to — ft.

From — ft. to — ft. From — ft. to — ft.

SAND GRAVEL PACK INTERVALS: From 4 ft. to 15 ft. From — ft. to — ft.

From — ft. to — ft. From — ft. to — ft.

6 GROUT MATERIAL: 1 Neat cement 2 Cement grout 3 Bentonite 4 Other —

Grout Intervals: From 2 GL ft. to 2 ft. From 2 ft. to 4 ft. From — ft. to — ft.

What is the nearest source of possible contamination: 10 Livestock pens 14 Abandoned water well

1 Septic tank 4 Lateral lines 7 Pit privy 11 Fuel storage 15 Oil well/Gas well

2 Sewer lines 5 Cess pool 8 Sewage lagoon 12 Fertilizer storage 16 Other (specify below)

3 Watertight sewer lines 6 Seepage pit 9 Feedyard 13 Insecticide storage Contaminated site

Direction from well? How many feet?

FROM TO LITHOLOGIC LOG FROM TO PLUGGING INTERVALS

0 1.0 Concrete Fill sand — —

1.0 15.0 Silty clay — —

15.0 TD END OF BOREHOLE — —

Flush mount waiver  
D. Taylor  
12-2-94

7 CONTRACTOR'S OR LANDOWNER'S CERTIFICATION: This water well was (1) constructed, (2) reconstructed, or (3) plugged under my jurisdiction and was completed on (mo/day/year) 12-27-94 and this record is true to the best of my knowledge and belief. Kansas

Water Well Contractor's License No. 585 This Water Well Record was completed on (mo/day/yr) 1-25-95

under the business name of Associated Environmental, Inc by (signature) Doris R. Duncan by Debra