


1 LOCATION OF WATER WELL: Fraction NE 1/4 SW 1/4 NE 1/4 Section Number 34 Township Number T 7 S Range Number R 11 E  
 County: Pottawatomie

Distance and direction from nearest town or city street address of well if located within city?

201 Leonard, Onaga, KS

2 WATER WELL OWNER: Onaga Oil Company Attn: K. Falk Board of Agriculture, Division of Water Resources  
 RR#, St. Address, Box #: 201 Leonard  
 City, State, ZIP Code: Onaga, KS 66521 Application Number: —

3 LOCATE WELL'S LOCATION WITH AN "X" IN SECTION BOX: 4 DEPTH OF COMPLETED WELL: 15 ft. ELEVATION: —

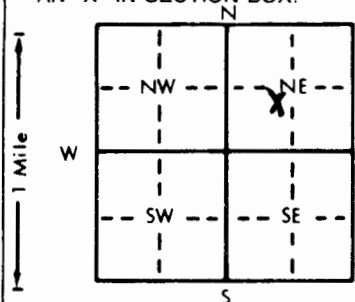

Depth(s) Groundwater Encountered 1. 10.5 ft. 2. — ft. 3. — ft.

WELL'S STATIC WATER LEVEL 6.29 ft. below land surface measured on mo/day/yr

Pump test data: Well water was — ft. after — hours pumping — gpm

Est. Yield — gpm: Well water was — ft. after — hours pumping — gpm

Bore Hole Diameter: 8.625 in. to 15 in. and — in. to — in.

WELL WATER TO BE USED AS: 5 Public water supply 8 Air conditioning 11 Injection well

1 Domestic 3 Feedlot 6 Oil field water supply 9 Dewatering 12 Other (Specify below)

2 Irrigation 4 Industrial 7 Lawn and garden only 10 Monitoring well mw-6

Was a chemical/bacteriological sample submitted to Department? Yes — No X; If yes, mo/day/yr sample was submitted

Water Well Disinfected? Yes — No X

5 TYPE OF BLANK CASING USED: 5 Wrought iron 8 Concrete tile CASING JOINTS: Glued — Clamped —

1 Steel 3 RMP (SR) 6 Asbestos-Cement 9 Other (specify below) Welded —

2 PVC 4 ABS 7 Fiberglass Threaded X

Blank casing diameter 2 in. to 15 in. Dia. — in. to — in.

Casing height above land surface: 0 in., weight Schedule 40 lbs./ft. Wall thickness or gauge No. —

TYPE OF SCREEN OR PERFORATION MATERIAL: 7 PVC 10 Asbestos-cement

1 Steel 3 Stainless steel 5 Fiberglass 8 RMP (SR) 11 Other (specify) —

2 Brass 4 Galvanized steel 6 Concrete tile 9 ABS 12 None used (open hole)

SCREEN OR PERFORATION OPENINGS ARE: 5 Gauzed wrapped 8 Saw cut 11 None (open hole)

1 Continuous slot 3 Mill slot 6 Wire wrapped 9 Drilled holes

2 Louvered shutter 4 Key punched 7 Torch cut 10 Other (specify) —

SCREEN-PERFORATED INTERVALS: From 5 ft. to 15 ft., From — ft. to — ft.

SAND From 4 ft. to 15 ft., From — ft. to — ft.

GRAVEL PACK INTERVALS: From — ft. to — ft., From — ft. to — ft.

6 GROUT MATERIAL: 1 Neat cement 2 Cement grout 3 Bentonite 4 Other —

Grout Intervals: From GL ft. to 2 ft., From 2 ft. to 4 ft., From — ft. to — ft.

What is the nearest source of possible contamination: 10 Livestock pens 14 Abandoned water well

1 Septic tank 4 Lateral lines 7 Pit privy 11 Fuel storage 15 Oil well/Gas well

2 Sewer lines 5 Cess pool 8 Sewage lagoon 12 Fertilizer storage 16 Other (specify below) contaminated site

3 Watertight sewer lines 6 Seepage pit 9 Feedyard 13 Insecticide storage

Direction from well? How many feet?

FROM TO LITHOLOGIC LOG FROM TO PLUGGING INTERVALS

0 7.0 Fill, gravel, surface silts/clays 0 7.0

7.0 8.5 Limestone, weathered 7.0 8.5

8.5 15.0 Shale 8.5 15.0

15.0 TD END OF BOREHOLE 15.0 TD

Flush mount waiver  
 D. Taylor  
 12-2-94

7 CONTRACTOR'S OR LANDOWNER'S CERTIFICATION: This water well was (1) constructed, (2) reconstructed, or (3) plugged under my jurisdiction and was completed on (mo/day/year) 1-5-95 and this record is true to the best of my knowledge and belief. Kansas

Water Well Contractor's License No. 585 This Water Well Record was completed on (mo/day/yr) 1-25-95

under the business name of Associated Environmental, Inc. by (signature) Dan R. Duncan by D. John