

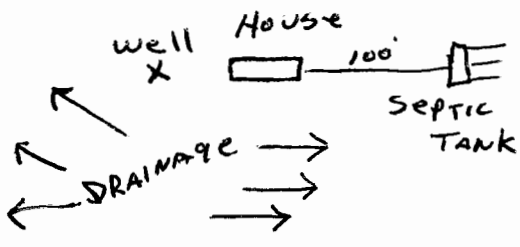
37

USE TYPEWRITER OR BALL POINT PEN-PRESS FIRMLY, PRINT CLEARLY.

WATER WELL RECORD
KSA 82a-1201-1215

Kansas Department of Health and Environment-Division of Environment (Water well Contractors) Topeka, Kansas 66620

Change
CBC

1. Location of well:	County JACKSON	Fraction NW SW 1/4 SW 1/4	Section number 23	Township number T 7	Range number S R 13
2. Distance and direction from nearest town or city: 10W 25 1W		3. Owner of well: CLINTON HARRIS			
Street address of well location if in city: .55 OF HOLTON		R.R. or street: City, state, zip code: PRI SOLDIER, KS.			
4. Locate with "X" in section below: N W E S 1 Mile		Sketch map: 		6. Bore hole dia. 10 in. Completion date _____ Well depth 50 ft. 2-24-76	
5. Type and color of material		From		To	
		TOP SOIL		0 4	
		BROWN CLAY		4 27	
		Pea gravel		27 32	
grey shale		32 50		7. <input checked="" type="checkbox"/> Cable tool <input checked="" type="checkbox"/> Rotary <input type="checkbox"/> Driven <input type="checkbox"/> Dug <input type="checkbox"/> Hollow rod <input type="checkbox"/> Jetted <input type="checkbox"/> Bored <input type="checkbox"/> Reverse rotary	
				8. Use: <input checked="" type="checkbox"/> Domestic <input type="checkbox"/> Public supply <input type="checkbox"/> Industry <input type="checkbox"/> Irrigation <input type="checkbox"/> Air conditioning <input type="checkbox"/> Stock <input type="checkbox"/> Lawn <input type="checkbox"/> Oil field water <input type="checkbox"/> Other	
				9. Casing: Material PVC Height: Above or below Threaded _____ Welded _____ Surface 29 in. RMP _____ PVC GL Weight 2.74 lbs./ft. MNC Dia. 5 in. to 50 ft. depth Wall Thickness: inches or Dia. _____ in. to _____ ft. depth gage No. 258	
				10. Screen: Manufacturer's name RUMPCO Type PVC Dia. 5" Slot gauze 0.06 Length 10' Set between 27 ft. and 37 ft. _____ ft. and _____ ft. Gravel pack? <input checked="" type="checkbox"/> Size range of material Y&L	
				11. Static water level: 1" mo./day/yr. 15 ft. below land surface Date 2-24-76	
				12. Pumping level below land surfaces: AIR TEST _____ ft. after _____ hrs. pumping _____ g.p.m. _____ ft. after _____ hrs. pumping _____ g.p.m. Estimated maximum yield 15 g.p.m.	
				13. Water sample submitted: _____ mo./day/yr. Yes <input checked="" type="checkbox"/> No <input type="checkbox"/> Date _____	
				14. Well head completion: CAPPED <input type="checkbox"/> Pitless adapter 24 inches above grade	
				15. Well grouted? <input checked="" type="checkbox"/> With: <input checked="" type="checkbox"/> Neat cement <input type="checkbox"/> Bentonite <input type="checkbox"/> Concrete Depth: From 0 ft. to 10 ft.	
				16. Nearest source of possible contamination: ft. 100 Direction E Type SEPTIC TANK Well disinfected upon completion? <input checked="" type="checkbox"/> Yes <input type="checkbox"/> No	
				17. Pump: <input checked="" type="checkbox"/> Not installed Manufacturer's name _____ Model number _____ HP _____ Volts _____ Length of drop pipe _____ ft. capacity _____ g.p.m. Type: <input type="checkbox"/> Submersible <input type="checkbox"/> Turbine <input type="checkbox"/> Jet <input type="checkbox"/> Reciprocating <input type="checkbox"/> Centrifugal <input type="checkbox"/> Other	
		(Use a second sheet if needed)			
18. Elevation: 1087 Topography: pa <input type="checkbox"/> Hill <input type="checkbox"/> Slope <input type="checkbox"/> Upland <input checked="" type="checkbox"/> Valley	19. Remarks: OWNER WILL INSTALL SLAB 2-27-100		20. Water well contractor's certification: This well was drilled under my jurisdiction and this report is true to the best of my knowledge and belief. STRADER Drly Co Inc 182 Business name _____ License No. _____ Address 671 Holton, KS Signed Dale Peshon Date 2-25-76 Authorized representative		

T 7
R 13
W
S
SW
NW
SE
NE
1/4
1/4
1/4
1/4

72
1075
55
1075