

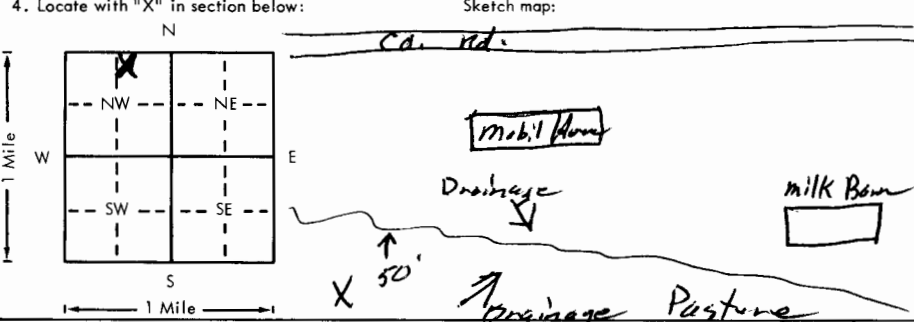
59

135

USE TYPEWRITER OR BALL POINT PEN-PRESS FIRMLY, PRINT CLEARLY.

WATER WELL RECORD
KSA 82a-1201-1215

Kansas Department of Health and Environment-Division of Environment
(Water well Contractors)
Topeka, Kansas 66620

1. Location of well: County: <u>Jackson</u>		Fraction: <u>NW 1/4 NE 1/4 NW 1/4</u>		Section number: <u>2</u>		Township number: <u>T 7 S R 14 E/W</u>		Range number: <u>14</u>	
2. Distance and direction from nearest town or city: <u>2 1/2 E</u> Street address of well location if in city: <u>Cherokee</u>				3. Owner of well: <u>Don ASKREAL JR.</u> R.R. or street: <u>RT1</u> City, state, zip code: <u>Holton, KS 66436</u>					
4. Locate with "X" in section below: 				6. Bore hole dia. <u>12</u> in. Completion date: <u>8-25-78</u> Well depth <u>92</u> ft.					
5. Type and color of material				From		To		7. Cable tool <input checked="" type="checkbox"/> Rotary <input type="checkbox"/> Driven <input type="checkbox"/> Dug <input type="checkbox"/> Hollow rod <input type="checkbox"/> Jetted <input type="checkbox"/> Bored <input type="checkbox"/> Reverse rotary	
<u>Top Soil</u>				<u>0</u>		<u>7</u>		8. Use: <input checked="" type="checkbox"/> Domestic <input type="checkbox"/> Public supply <input type="checkbox"/> Industry <input type="checkbox"/> Irrigation <input type="checkbox"/> Air conditioning <input type="checkbox"/> Stock <input type="checkbox"/> Lawn <input type="checkbox"/> Oil field water <input type="checkbox"/> Other	
<u>Black loam</u>				<u>7</u>		<u>10</u>		9. Casing: Material <u>PVC</u> Height <u>Above</u> or below Threaded <input type="checkbox"/> Welded <input type="checkbox"/> Surface <u>24</u> in. RMP <u>PVC Blue</u> Weight <u>2.74</u> lbs./ft. Dia. <u>5</u> in. to <u>92</u> ft. depth Wall Thickness: inches or Dia. <u> </u> in. to <u> </u> ft. depth gage No. <u>1258</u>	
<u>Brown Clay</u>				<u>10</u>		<u>29</u>		10. Screen: Manufacturer's name <u>Pumped</u> Type <u>PVC</u> Dia. <u>5</u> <u>30</u> gauze <u>020</u> Length <u>60</u> Set between <u>25</u> ft. and <u>75</u> ft. <u>92</u> ft. and <u>92</u> ft. Gravel pack? <input checked="" type="checkbox"/> Size range of material <u>030/060</u>	
<u>Coarse Pea Gravel 1 x 1/2</u>				<u>29</u>		<u>33</u>		11. Static water level: <u>8</u> mo./day/yr. <u>8</u> ft. below land surface Date <u>8-25-78</u>	
<u>Brown Clay</u>				<u>33</u>		<u>36</u>		12. Pumping level below land surfaces: <u>Air test</u> <u> </u> ft. after <u> </u> hrs. pumping <u> </u> g.p.m. <u> </u> ft. after <u> </u> hrs. pumping <u> </u> g.p.m. Estimated maximum yield <u>10</u> g.p.m.	
<u>White Gray Pea Cherty Gravel</u>				<u>36</u>		<u>41</u>		13. Water sample submitted: <u> </u> mo./day/yr. <input type="checkbox"/> Yes <input checked="" type="checkbox"/> No Date <u> </u>	
<u>Gray Gravelly Clay</u>				<u>41</u>		<u>52</u>		14. Well head completion: <u>Top cap</u> <input checked="" type="checkbox"/> Pitless adapter <u>24</u> Inches above grade	
<u>Gray Fine Sand</u>				<u>52</u>		<u>61</u>		15. Well grouted? <u>Yes</u> With: <input checked="" type="checkbox"/> Neat cement <input type="checkbox"/> Bentonite <input type="checkbox"/> Concrete Depth: From <u>0</u> ft. to <u>10</u> ft.	
<u>Gray Pea Chert & Fine Sand</u>				<u>61</u>		<u>92</u>		16. Nearest source of possible contamination: <u>Field</u> ft. <u>50</u> Direction <u>North</u> Type <u>Drainage</u> Well disinfected upon completion? <input checked="" type="checkbox"/> Yes <input type="checkbox"/> No	
								17. Pump: <input checked="" type="checkbox"/> Not installed Manufacturer's name <u>Pumped</u> Model number <u>1058</u> HP <u>1/2</u> Volts <u>230</u> Length of drop pipe <u>60</u> ft. capacity <u>10</u> g.p.m. Type: <input checked="" type="checkbox"/> Submersible <input type="checkbox"/> Turbine <input type="checkbox"/> Jet <input type="checkbox"/> Reciprocating <input type="checkbox"/> Centrifugal <input type="checkbox"/> Other	
18. Elevation: <u>1140</u>				19. Remarks: <u>owner to install slab</u>		20. Water well contractor's certification: This well was drilled under my jurisdiction and this report is true to the best of my knowledge and belief. <u>Stander Dalg Co Inc 182</u> Business name License No. <u> </u> Address <u>RT1 Holton, KS</u> Signed <u>Dale Ashum</u> Date <u>8-28-78</u> Authorized representative			
Topography: <input type="checkbox"/> Hill <input type="checkbox"/> Slope <input checked="" type="checkbox"/> Upland <input type="checkbox"/> Valley									

T
R
W
Sec
1/4
1/4
1/4
1/4
NAME NW