


1 LOCATION OF WATER WELL: Fraction NW 1/4 NW 1/4 SE 1/4 Section Number 10 Township Number T 7 S Range Number R 14 EW

Distance and direction from nearest town or city street address of well if located within city?
 4 1/2 W + 1/2 S Holton, Ks.

2 WATER WELL OWNER: Ray DeVader
 RR#, St. Address, Box # : Rt. 1 Board of Agriculture, Division of Water Resources
 City, State, ZIP Code : Holton, KS 66436 Application Number:

3 LOCATE WELL'S LOCATION WITH AN "X" IN SECTION BOX:

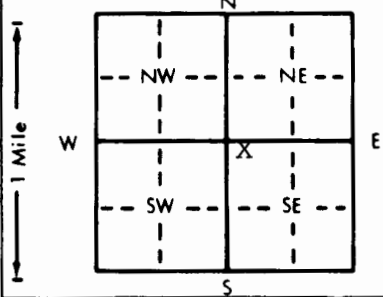

4 DEPTH OF COMPLETED WELL: 80 ft. ELEVATION:ft.
 Depth(s) Groundwater Encountered 1. 55' ft. 2.ft. 3.ft.
 WELL'S STATIC WATER LEVEL: 50' ft. below land surface measured on mo/day/yr 10-11-88
 Pump test data: Well water wasft. after hours pumping gpm
 Est. Yield: 15 gpm: Well water wasft. after hours pumping gpm
 Bore Hole Diameter: 8 3/4" in. toft., andin. toft.
 WELL WATER TO BE USED AS:
 1 Domestic 3 Feedlot 5 Public water supply 8 Air conditioning 11 Injection well
 2 Irrigation 4 Industrial 6 Oil field water supply 9 Dewatering 12 Other (Specify below)
 7 Lawn and garden only 10 Monitoring well
 Was a chemical/bacteriological sample submitted to Department? Yes.....No X; If yes, mo/day/yr sample was submitted
 Water Well Disinfected? Yes X No

5 TYPE OF BLANK CASING USED:
 1 Steel 3 RMP (SR) 5 Wrought iron 8 Concrete tile CASING JOINTS: Glued X Clamped
 2 PVC 4 ABS 6 Asbestos-Cement 9 Other (specify below) Welded
 7 Fiberglass Threaded.....

Blank casing diameter: 5" in. to 0-52 ft., Dia: 5" in. to 60-80 ft., Dia:in. toft.
 Casing height above land surface: 24" in., weight: 2.82 lbs./ft. Wall thickness or gauge No.: 258

TYPE OF SCREEN OR PERFORATION MATERIAL:
 1 Steel 3 Stainless steel 5 Fiberglass 7 PVC 10 Asbestos-cement
 2 Brass 4 Galvanized steel 6 Concrete tile 8 RMP (SR) 11 Other (specify)
 9 ABS 12 None used (open hole)

SCREEN OR PERFORATION OPENINGS ARE:
 1 Continuous slot 3 Mill slot 5 Gauzed wrapped 8 Saw cut 11 None (open hole)
 2 Louvered shutter 4 Key punched 6 Wire wrapped 9 Drilled holes
 7 Torch cut 10 Other (specify)

SCREEN-PERFORATED INTERVALS: From 52 ft. to 60 ft., Fromft. toft.
 Fromft. toft., Fromft. toft.
 GRAVEL PACK INTERVALS: From 23 ft. to 80 ft., Fromft. toft.
 Fromft. toft., Fromft. toft.

6 GROUT MATERIAL: 1 Neat cement 2 Cement grout 3 Bentonite 4 Other
 Grout Intervals: From 3 ft. to 23 ft., Fromft. toft., Fromft. toft.

What is the nearest source of possible contamination:
 1 Septic tank 4 Lateral lines 7 Pit privy 10 Livestock pens 14 Abandoned water well
 2 Sewer lines 5 Cess pool 8 Sewage lagoon 11 Fuel storage 15 Oil well/Gas well
 3 Watertight sewer lines 6 Seepage pit 9 Feedyard 12 Fertilizer storage 16 Other (specify below)
 13 Insecticide storage
 Direction from well? NW How many feet? 210

FROM	TO	LITHOLOGIC LOG	FROM	TO	PLUGGING INTERVALS
0	2	Top Soil			
2	33	Clay-Brown			
33	53	Shale-Yellow			
53	56	Limestone-Loose-Grey			
56	80	Shale-Grey			

7 CONTRACTOR'S OR LANDOWNER'S CERTIFICATION: This water well was (1) constructed, (2) reconstructed, or (3) plugged under my jurisdiction and was completed on (mo/day/year) 10-11-88 and this record is true to the best of my knowledge and belief. Kansas Water Well Contractor's License No. 182 This Water Well Record was completed on (mo/day/yr) 11-21-88 under the business name of Strader Drilling Co., Inc. by (signature) *W. Strader*