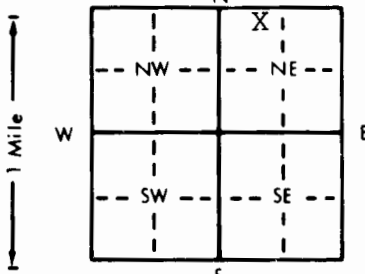


1 LOCATION OF WATER WELL: County: JACKSON	Fraction NE 1/4 NW 1/4 NE 1/4	Section Number 18 12	Township Number T 7 S	Range Number R 14 E/W
--	----------------------------------	------------------------------------	--------------------------	--------------------------

Distance and direction from nearest town or city street address of well if located within city?

2 miles west of Holton

2 WATER WELL OWNER: Ray Paxton
 RR#, St. Address, Box # :
 City, State, ZIP Code : Holton, KS 66436
 Board of Agriculture, Division of Water Resources
 Application Number:

3 LOCATE WELL'S LOCATION WITH AN "X" IN SECTION BOX: 	4 DEPTH OF COMPLETED WELL... 124' ft. ELEVATION: Depth(s) Groundwater Encountered 1. ft. 2. ft. 3. ft. WELL'S STATIC WATER LEVEL... 40' ft. below land surface measured on mo/day/yr 05/19/98 Pump test data: Well water was ft. after hours pumping gpm Est. Yield .20. gpm: Well water was ft. after hours pumping gpm Bore Hole Diameter... 12" in. to ft., and in. to ft. WELL WATER TO BE USED AS: 5 Public water supply 8 Air conditioning 11 Injection well 1 Domestic 3 Feedlot 6 Oil field water supply 9 Dewatering 12 Other (Specify below) 2 Irrigation 4 Industrial 7 Lawn and garden only 10 Monitoring well Was a chemical/bacteriological sample submitted to Department? Yes.....No...X...; If yes, mo/day/yr sample was submitted Water Well Disinfected? Yes X No
--	---

5 TYPE OF BLANK CASING USED:
 1 Steel 3 RMP (SR) 5 Wrought iron 8 Concrete tile CASING JOINTS: Glued X Clamped
 2 PVC 4 ABS 6 Asbestos-Cement 9 Other (specify below) Welded
 7 Fiberglass Threaded
 Blank casing diameter 5" in. to 0-51 ft., Dia 5" in. to 56-72 ft., Dia
 Casing height above land surface 24" in., weight 2.82 lbs./ft. Wall thickness or gauge No. 258
 TYPE OF SCREEN OR PERFORATION MATERIAL:
 1 Steel 3 Stainless steel 5 Fiberglass 7 PVC 10 Asbestos-cement
 2 Brass 4 Galvanized steel 6 Concrete tile 8 RMP (SR) 11 Other (specify)
 SCREEN OR PERFORATION OPENINGS ARE:
 1 Continuous slot 3 Mill slot 5 Gauzed wrapped 8 Saw cut 11 None (open hole)
 2 Louvered shutter 4 Key punched 6 Wire wrapped 9 Drilled holes
 7 Torch cut 10 Other (specify)
 SCREEN-PERFORATED INTERVALS: From 51 ft. to 56 ft., From 72 ft. to 77 ft.,
 GRAVEL PACK INTERVALS: From 24 ft. to 124 ft.,

6 GROUT MATERIAL: 1 Neat cement 2 Cement grout 3 Bentonite 4 Other
 Grout Intervals: From 4 ft. to 24 ft., From ft. to ft., From ft. to ft.
 What is the nearest source of possible contamination:
 1 Septic tank 4 Lateral lines 7 Pit privy 10 Livestock pens 14 Abandoned water well
 2 Sewer lines 5 Cess pool 8 Sewage lagoon 11 Fuel storage 15 Oil well/Gas well
 3 Watertight sewer lines 6 Seepage pit 9 Feedyard 12 Fertilizer storage 16 Other (specify below)
 13 Insecticide storage
 Direction from well? south How many feet? 300'

FROM	TO	LITHOLOGIC LOG	FROM	TO	PLUGGING INTERVALS
0	1	Top Soil			
1	38	Clay-Grey			
38	47	Clay-Grey			
47	50	Clay-Brown			
50	55	Fine Sand-Brown			
55	61	Clay-Brown			
61	71	Clay-Grey			
71	75	Fine Sand-Brown			
75	117	Clay-Grey			
117	118	Boulder-Limestone			
118	123	Clay-Grey			
123	124	Limestone-Tan			

7 CONTRACTOR'S OR LANDOWNER'S CERTIFICATION: This water well was (1) constructed, (2) reconstructed, or (3) plugged under my jurisdiction and was completed on (mo/day/year) 5/19/98 and this record is true to the best of my knowledge and belief. Kansas Water Well Contractor's License No. 182 This Water Well Record was completed on (mo/day/year) 6-3-98 under the business name of STRADER DRILLING CO., INC. by (signature) Dale Strader