


1 LOCATION OF WATER WELL: County: Jackson Fraction: SE 1/4 SE 1/4 SW 1/4 Section Number: 12 Township Number: T 7 S Range Number: R 14E E/W

Distance and direction from nearest town or city street address of well if located within city? 1/2 south, 2 1/2 west of Holton **PLUGGING REPORT #9**

2 WATER WELL OWNER: Jackson Co. - Banner Creek Reservoir
 RR#, St. Address, Box #: Co. Commission - Courthouse Board of Agriculture, Division of Water Resources
 City, State, ZIP Code: Holton, KS 66436 Application Number:

3 LOCATE WELL'S LOCATION WITH AN "X" IN SECTION BOX:

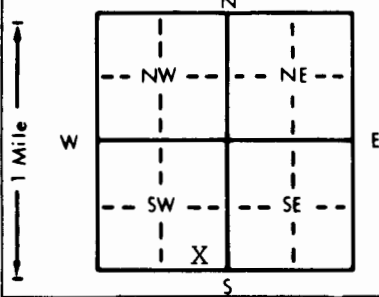

4 DEPTH OF COMPLETED WELL... 70' ft. ELEVATION:

Depth(s) Groundwater Encountered 1. ft. 2. ft. 3. ft.
 WELL'S STATIC WATER LEVEL ... 5.5 ft. below land surface measured on mo/day/yr 1-26-95
 Pump test data: Well water was ... ft. after ... hours pumping ... gpm
 Est. Yield ... gpm: Well water was ... ft. after ... hours pumping ... gpm
 Bore Hole Diameter ... 6 in. to ... ft., and ... in. to ... ft.
 WELL WATER TO BE USED AS: 5 Public water supply 8 Air conditioning 11 Injection well
 1 Domestic 3 Feedlot 6 Oil field water supply 9 Dewatering 12 Other (Specify below)
 2 Irrigation 4 Industrial 7 Lawn and garden only 10 Monitoring well
 Was a chemical/bacteriological sample submitted to Department? Yes.....No...X.....; If yes, mo/day/yr sample was submitted
 Water Well Disinfected? Yes X No

5 TYPE OF BLANK CASING USED: 5 Wrought iron 8 Concrete tile CASING JOINTS: Glued Clamped

Blank casing diameter ... 6 in. to ... ft., Dia ... in. to ... ft., Dia ... in. to ... ft.
 Casing height above land surface ... LC in., weight ... lbs./ft. Wall thickness or gauge No.
 TYPE OF SCREEN OR PERFORATION MATERIAL: 7 PVC 10 Asbestos-cement
 1 Steel 3 Stainless steel 5 Fiberglass 8 RMP (SR) 11 Other (specify) NA
 2 Brass 4 Galvanized steel 6 Concrete tile 9 ABS 12 None used (open hole)

SCREEN OR PERFORATION OPENINGS ARE: 5 Gauzed wrapped 8 Saw cut 11 None (open hole)
 1 Continuous slot 3 Mill slot 6 Wire wrapped 9 Drilled holes
 2 Louvered shutter 4 Key punched 7 Torch cut 10 Other (specify) NA

SCREEN-PERFORATED INTERVALS: From... NA ft. to ... ft., From ... ft. to ... ft.
 GRAVEL PACK INTERVALS: From ... ft. to ... ft., From ... ft. to ... ft.

6 GROUT MATERIAL: 1 Neat cement 2 Cement grout 3 Bentonite 4 Other

Grout Intervals: From... 10 ft. to ... 3 ft., From ... ft. to ... ft., From ... ft. to ... ft.
 What is the nearest source of possible contamination: 10 Livestock pens 14 Abandoned water well
 1 Septic tank 4 Lateral lines 7 Pit privy 11 Fuel storage 15 Oil well/Gas well
 2 Sewer lines 5 Cess pool 8 Sewage lagoon 12 Fertilizer storage 16 Other (specify below)
 3 Watertight sewer lines 6 Seepage pit 9 Feedyard 13 Insecticide storage

Direction from well? How many feet?

FROM	TO	LITHOLOGIC LOG	FROM	TO	PLUGGING INTERVALS
			0	3	Clay (casing removed to 3')
			3	10	Bentonite (1.4 cu. ft.)
			10	70	Gravel (12 cu. ft.)

7 CONTRACTOR'S OR LANDOWNER'S CERTIFICATION: This water well was (1) constructed, (2) reconstructed, or (3) plugged under my jurisdiction and was completed on (mo/day/year) ... 1-26-95 ... and this record is true to the best of my knowledge and belief. Kansas Water Well Contractor's License No. ... 182 ... This Water Well Record was completed on (mo/day/yr) 3-1-95 ... under the business name of STRADER DRILLING CO., INC. by (signature) Dale Strader