


1 LOCATION OF WATER WELL:
County: Jackson
Fraction: NW 1/4 SE 1/4 SW 1/4
Section Number: 3
Township Number: T 7 S
Range Number: R 15 EW

Distance and direction from nearest town or city street address of well if located within city?
5th & New Jersey

2 WATER WELL OWNER: Kathy Smith
RR#, St. Address, Box #: RT 2 Box 545
City, State, ZIP Code: Holton, Ks. 66436
Board of Agriculture, Division of Water Resources
Application Number:

3 LOCATE WELL'S LOCATION WITH AN 'X' IN SECTION BOX:
4 DEPTH OF COMPLETED WELL: 23 ft. ELEVATION: 1071.94

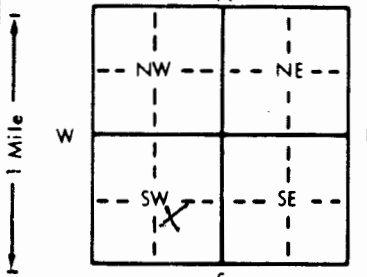

Depth(s) Groundwater Encountered: 1. 18 ft. 2. ft. 3. ft.
WELL'S STATIC WATER LEVEL 22.57 ft. below land surface measured on 6-4-93
Pump test data: Well water was ft. after hours pumping gpm
Est. Yield gpm: Well water was ft. after hours pumping gpm
Bore Hole Diameter: 7 5/8 in. to 23 ft. and in. to ft.
WELL WATER TO BE USED AS:
1 Domestic 3 Feedlot 6 Oil field water supply 9 Dewatering 12 Other (Specify below)
2 Irrigation 4 Industrial 7 Lawn and garden only 10 Monitoring well
Was a chemical/bacteriological sample submitted to Department? Yes No: If yes, mo/day/yr sample was submitted

5 TYPE OF BLANK CASING USED:
1 Steel 3 RMP (SR) 5 Wrought iron 8 Concrete tile CASING JOINTS: Glued Clamped
2 PVC 4 ABS 6 Asbestos-Cement 9 Other (specify below) Welded
7 Fiberglass Threaded
Blank casing diameter: 2 in. to 13 ft., Dia. in. to ft., Dia. in. to ft.
Casing height above land surface: 40 in., weight lbs. ft. Wall thickness or gauge No. Sch. 40

TYPE OF SCREEN OR PERFORATION MATERIAL:
1 Steel 3 Stainless steel 5 Fiberglass 8 RMP (SR) 10 Asbestos-cement
2 Brass 4 Galvanized steel 6 Concrete tile 9 ABS 11 Other (specify)
12 None used (open hole)

SCREEN OR PERFORATION OPENINGS ARE:
1 Continuous slot 3 Mill slot 5 Gauzed wrapped 8 Saw cut 11 None (open hole)
2 Louvered shutter 4 Key punched 6 Wire wrapped 9 Drilled holes
7 Torch cut 10 Other (specify)

SCREEN-PERFORATED INTERVALS: From 13 ft. to 23 ft., From ft. to ft.
GRAVEL PACK INTERVALS: From 11 ft. to 13 ft., From ft. to ft.

6 GROUT MATERIAL: 1 Neat cement 2 Cement grout 3 Bentonite 4 Other
Grout Intervals: From 0 ft. to 9 ft., From 9 ft. to 11 ft., From ft. to ft.

What is the nearest source of possible contamination:
1 Septic tank 4 Lateral lines 7 Pit privy 10 Livestock pens 14 Abandoned water well
2 Sewer lines 5 Cess pool 8 Sewage lagoon 11 Fuel storage 15 Oil well/Gas well
3 Watertight sewer lines 6 Seepage pit 9 Feedyard 12 Fertilizer storage 16 Other (specify below)
13 Insecticide storage
Direction from well? West How many feet? 7

Table with columns: FROM, TO, LITHOLOGIC LOG, FROM, TO, PLUGGING INTERVALS.
Row 1: 0, 4, Topsoil, brn/blk, , ,
Row 2: 4, 10, Clay bl/grn, , , MW 1
Row 3: 10, 19, Clay, rd/brn, tr snd, , ,
Row 4: 19, 23, Sand, gy/brn, med, , ,

7 CONTRACTOR'S OR LANDOWNER'S CERTIFICATION: This water well was (1) constructed, (2) reconstructed, or (3) plugged under my jurisdiction and was completed on (mo/day/year) 4-12-93 and this record is true to the best of my knowledge and belief. Kansas Water Well Contractor's License No. 527 This Water Well Record was completed on (mo/day/yr) 7-8-93 under the business name of GeoCore Services, Inc. by (signature) Dale Bell