


1 LOCATION OF WATER WELL: County: Jackson Fraction: SE 1/4 SE 1/4 SE 1/4 Section Number: 4 Township Number: T 7 S Range Number: R 15 EW

Distance and direction from nearest town or city street address of well if located within city?
Northwest Corner of Hwy 75+116 in Holton, Ks

2 WATER WELL OWNER: Coastal Corp - Coastal Remediation
 RR#, St. Address, Box #: 710 Asp Ave. Suite A Board of Agriculture, Division of Water Resources
 City, State, ZIP Code: Norman, OKla 73069 Application Number:

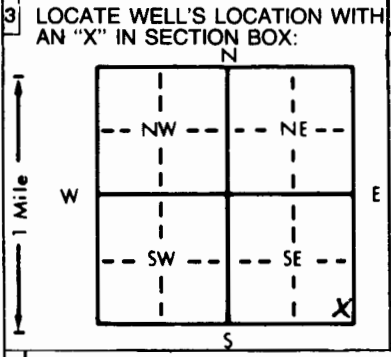

4 DEPTH OF COMPLETED WELL: 20 ft. ELEVATION:
 Depth(s) Groundwater Encountered 1. 14 1/2 ft. 2. ft. 3. ft.
 WELL'S STATIC WATER LEVEL: 16 ft. below land surface measured on mo/day/yr 2/21/92
 Pump test data: Well water was ft. after hours pumping gpm
 Est. Yield gpm: Well water was ft. after hours pumping gpm
 Bore Hole Diameter: 7 in. to 20 ft., and in. to ft.
 WELL WATER TO BE USED AS:
 1 Domestic 2 Irrigation 3 Feedlot 4 Industrial 5 Public water supply 6 Oil field water supply 7 Lawn and garden only 8 Air conditioning 9 Dewatering 10 Monitoring well 11 Injection well 12 Other (Specify below)
 Was a chemical/bacteriological sample submitted to Department? Yes No X; If yes, mo/day/yr sample was submitted Water Well Disinfected? Yes No

5 TYPE OF BLANK CASING USED:
 1 Steel 2 PVC 3 RMP (SR) 4 ABS 5 Wrought iron 6 Asbestos-Cement 7 Fiberglass 8 Concrete tile 9 Other (specify below) CASING JOINTS: Glued Clamped Welded Threaded X
 Blank casing diameter: 4.42 in. to 10 ft., Dia. in. to ft., Dia. in. to ft.
 Casing height above land surface: Flush Mount in., weight lbs./ft. Wall thickness or gauge No. SDR-13
 TYPE OF SCREEN OR PERFORATION MATERIAL:
 1 Steel 2 Brass 3 Stainless steel 4 Galvanized steel 5 Fiberglass 6 Concrete tile 7 PVC 8 RMP (SR) 9 ABS 10 Asbestos-cement 11 Other (specify) 12 None used (open hole)
 SCREEN OR PERFORATION OPENINGS ARE:
 1 Continuous slot 2 Louvered shutter 3 Mill slot 4 Key punched 5 Gauzed wrapped 6 Wire wrapped 7 Torch cut 8 Saw cut 9 Drilled holes 10 Other (specify) 11 None (open hole)
 SCREEN-PERFORATED INTERVALS: From 20 ft. to 10 ft., From ft. to ft.
 GRAVEL PACK INTERVALS: From 20 ft. to 8 ft., From ft. to ft.

6 GROUT MATERIAL: 1 Neat cement 2 Cement grout 3 Bentonite 4 Other
 Grout Intervals: From 8 ft. to 2 ft., From 2 ft. to 0 ft., From ft. to ft.
 What is the nearest source of possible contamination:
 1 Septic tank 2 Sewer lines 3 Watertight sewer lines 4 Lateral lines 5 Cess pool 6 Seepage pit 7 Pit privy 8 Sewage lagoon 9 Feedyard 10 Livestock pens 11 Fuel storage 12 Fertilizer storage 13 Insecticide storage 14 Abandoned water well 15 Oil well/Gas well 16 Other (specify below) Abandoned gas station
 Direction from well? How many feet?

FROM	TO	LITHOLOGIC LOG	FROM	TO	PLUGGING INTERVALS
0	1/2 ft	Asphalt w/gravel fill			
1/2 ft	2	Black-Red silty clay w/ls. re. frag.			
2	4	Blue-green-gray mottled clay w/ls. re. frag.			
4	8	Black silty clay			
8	10 1/2	Reddish-brown silty clay w/fine sand & ls. re. frag.			
10 1/2	14 1/2	Reddish-brown silty sandy clay w/fine med. sand & gravel			
14 1/2	20	Reddish-brown silty sandy clay w/fine med. grain sand and small ls. re. frag.			

7 CONTRACTOR'S OR LANDOWNER'S CERTIFICATION: This water well was (1) constructed, (2) reconstructed, or (3) plugged under my jurisdiction and was completed on (mo/day/year) 2/21/92 and this record is true to the best of my knowledge and belief. Kansas Water Well Contractor's License No. 539 This Water Well Record was completed on (mo/day/yr) 2/22/92 under the business name of GB Environmental Drilling by (signature) James Sieber