


1 LOCATION OF WATER WELL: Fraction SE 1/4 SE 1/4 SE 1/4 Section Number 4 Township Number T 7 S Range Number R 15 EW  
 County: Jackson

Distance and direction from nearest town or city street address of well if located within city?

North West Corner of Hwy 754116 in Holton, KS.

2 WATER WELL OWNER: Coastal Remediation - Coastal Corp.  
 RR#, St. Address, Box #: 710 Asp Ave. Suite A Board of Agriculture, Division of Water Resources  
 City, State, ZIP Code: Norman, Okla. 73069 Application Number:

3 LOCATE WELL'S LOCATION WITH AN "X" IN SECTION BOX:

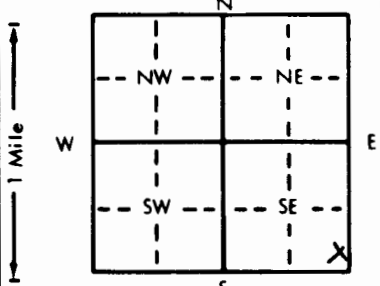

4 DEPTH OF COMPLETED WELL: 29 ft. ft. ELEVATION:

Depth(s) Groundwater Encountered 1. 26 ft. ft. 2. ft. 3. ft.

WELL'S STATIC WATER LEVEL: 26.3 ft. below land surface measured on mo/day/yr 2/21/92

Pump test data: Well water was ft. after hours pumping gpm

Est. Yield gpm: Well water was ft. after hours pumping gpm

Bore Hole Diameter: 6.518 in. to 29 ft. ft., and in. to ft.

WELL WATER TO BE USED AS: 5 Public water supply 8 Air conditioning 11 Injection well  
 1 Domestic 3 Feedlot 6 Oil field water supply 9 Dewatering 12 Other (Specify below)  
 2 Irrigation 4 Industrial 7 Lawn and garden only 10 Monitoring well

Was a chemical/bacteriological sample submitted to Department? Yes No X; If yes, mo/day/yr sample was submitted

Water Well Disinfected? Yes No

5 TYPE OF BLANK CASING USED: 5 Wrought iron 8 Concrete tile CASING JOINTS: Glued Clamped  
 1 Steel 3 RMP (SR) 6 Asbestos-Cement 9 Other (specify below) Welded  
2 PVC 4 ABS 7 Fiberglass Threaded X

Blank casing diameter: 2.41 in. to 19 ft., Dia. in. to ft., Dia. in. to ft.

Casing height above land surface: Flush Mount in., weight lbs./ft. Wall thickness or gauge No. SDR-13 Sch 40

TYPE OF SCREEN OR PERFORATION MATERIAL: 7 PVC 10 Asbestos-cement  
 1 Steel 3 Stainless steel 5 Fiberglass 8 RMP (SR) 11 Other (specify)  
 2 Brass 4 Galvanized steel 6 Concrete tile 9 ABS 12 None used (open hole)

SCREEN OR PERFORATION OPENINGS ARE: 5 Gauzed wrapped 8 Saw cut 11 None (open hole)  
 1 Continuous slot 3 Mill slot .010 6 Wire wrapped 9 Drilled holes  
 2 Louvered shutter 4 Key punched 7 Torch cut 10 Other (specify)

SCREEN-PERFORATED INTERVALS: From 29 ft. to 19 ft., From ft. to ft.

GRAVEL PACK INTERVALS: From 29 ft. to 18 ft., From ft. to ft.

6 GROUT MATERIAL: 1 Neat cement 2 Cement grout 3 Bentonite 4 Other  
 Grout Intervals: From 18 ft. to 3 ft., From 3 ft. to 0 ft., From ft. to ft.

What is the nearest source of possible contamination: 3 10 Livestock pens 14 Abandoned water well  
 1 Septic tank 4 Lateral lines 7 Pit privy 11 Fuel storage 15 Oil well/Gas well  
 2 Sewer lines 5 Cess pool 8 Sewage lagoon 12 Fertilizer storage 16 Other (specify below)  
 3 Watertight sewer lines 6 Seepage pit 9 Feedyard 13 Insecticide storage Abandoned Fuel Storage Tanks

Direction from well? How many feet?

FROM	TO	LITHOLOGIC LOG	FROM	TO	PLUGGING INTERVALS
0	1	Asphalt w/gravel backfill			
1	5	Mottled olive green to black silty clay			
5	10 1/2	Red till - silty clay w/ gravel & fine grained sand			
10 1/2	14	Reddish Green mottled silty till w/ gravel			
14	18	Fine-med. grained silty yellow brown sand			
18	29	Red Brown silty sand, fine-med. grained sand & gravel			
29		Ls. Bedrock			

7 CONTRACTOR'S OR LANDOWNER'S CERTIFICATION: This water well was (1) constructed, (2) reconstructed, or (3) plugged under my jurisdiction and was completed on (mo/day/year) 2/21/92 and this record is true to the best of my knowledge and belief. Kansas Water Well Contractor's License No. 539 This Water Well Record was completed on (mo/day/yr) 2/22/92 under the business name of J.B. Environmental Drilling by (signature) James Bieker