


1 LOCATION OF WATER WELL: County: Jackson Fraction: SE 1/4 SE 1/4 SE 1/4 Section Number: 4 Township Number: T 7 S Range Number: R 15 EW

Distance and direction from nearest town or city street address of well if located within city?
Northwest corner of intersection of Hwy 75-116 in Holton, Ks

2 WATER WELL OWNER: Coastal Corp - Coastal Remediation
 RR#, St. Address, Box #: 710 Asp Ave - Suite A Board of Agriculture, Division of Water Resources
 City, State, ZIP Code: Norman, Okla. 73069 Application Number:

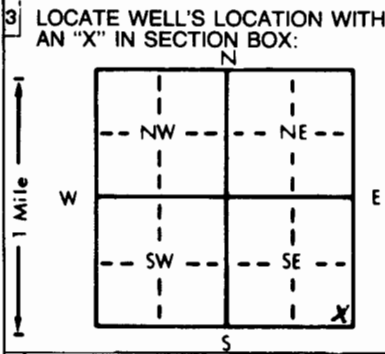

4 DEPTH OF COMPLETED WELL: 29 1/2 ft. ELEVATION:
 Depth(s) Groundwater Encountered 1. 25 1/2 ft. 2. ft. 3. ft.
 WELL'S STATIC WATER LEVEL: 26 ft. below land surface measured on mo/day/yr 2/21/92
 Pump test data: Well water was ft. after hours pumping gpm
 Est. Yield gpm: Well water was ft. after hours pumping gpm
 Bore Hole Diameter: 7" in. to 29 1/2 ft ft., and in. to ft.
 WELL WATER TO BE USED AS:
 5 Public water supply 8 Air conditioning 11 Injection well
 1 Domestic 3 Feedlot 6 Oil field water supply 9 Dewatering 12 Other (Specify below)
 2 Irrigation 4 Industrial 7 Lawn and garden only 10 Monitoring well
 Was a chemical/bacteriological sample submitted to Department? Yes. No. X If yes, mo/day/yr sample was submitted
 Water Well Disinfected? Yes No X

5 TYPE OF BLANK CASING USED:
 1 Steel 3 RMP (SR) 5 Wrought iron 8 Concrete tile CASING JOINTS: Glued Clamped
2 PVC 4 ABS 6 Asbestos-Cement 9 Other (specify below) Welded
 Blank casing diameter: 2 1/4 in. to 19 in. Dia in. to in. Dia in. to in. to ft.
 Casing height above land surface: Flush Mount in., weight lbs./ft. Wall thickness or gauge No. SDR-13
 TYPE OF SCREEN OR PERFORATION MATERIAL: 7 PVC 10 Asbestos-cement Sch 40
 1 Steel 3 Stainless steel 5 Fiberglass 8 RMP (SR) 11 Other (specify)
 2 Brass 4 Galvanized steel 6 Concrete tile 9 ABS 12 None used (open hole)
 SCREEN OR PERFORATION OPENINGS ARE:
 1 Continuous slot 3 Mill slot .010 5 Gauzed wrapped 8 Saw cut 11 None (open hole)
 2 Louvered shutter 4 Key punched 6 Wire wrapped 9 Drilled holes
 7 Torch cut 10 Other (specify)
 SCREEN-PERFORATED INTERVALS: From 29 ft. to 19 ft. From ft. to ft.
 From ft. to ft. From ft. to ft.
 GRAVEL PACK INTERVALS: From 29 ft. to 22 ft. From ft. to ft.
 From ft. to ft. From ft. to ft.

6 GROUT MATERIAL: 1 Neat cement 2 Cement grout 3 Bentonite 4 Other Clay
 Grout Intervals: From 22 ft. to 14 ft. From 14 ft. to 3 ft. From 3 ft. to 0 ft.
 What is the nearest source of possible contamination:
 1 Septic tank 4 Lateral lines 7 Pit privy 10 Livestock pens 14 Abandoned water well
 2 Sewer lines 5 Cess pool 8 Sewage lagoon 11 Fuel storage 15 Oil well/Gas well
 3 Watertight sewer lines 6 Seepage pit 9 Feedyard 12 Fertilizer storage 16 Other (specify below)
Abandon Fuel Storage
 Direction from well? How many feet?

FROM	TO	LITHOLOGIC LOG	FROM	TO	PLUGGING INTERVALS
0	3/4	Asphalt w/gravel			
3/4	33/4	Blue-green-gray brown mottled clay			
33/4	83/4	Black silty clay - root fragments			
83/4	101/4	Brown silty sandy clay			
101/4	171/2	Yellow-gray silty sand - fine-med sand			
171/2	291/2	Yellow-gray silty sand w/ fine sand and small b.r.x. frag.			

7 CONTRACTOR'S OR LANDOWNER'S CERTIFICATION: This water well was (1) constructed, (2) reconstructed, or (3) plugged under my jurisdiction and was completed on (mo/day/year) 2/21/92 and this record is true to the best of my knowledge and belief. Kansas Water Well Contractor's License No. 539 This Water Well Record was completed on (mo/day/yr) 2/22/92 under the business name of JB Environmental Drilling by (signature) James Breker