

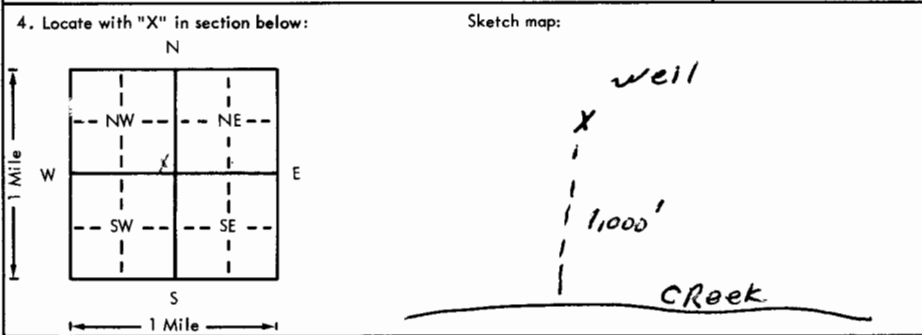
14

USE TYPEWRITER OR BALL POINT PEN—PRESS FIRMLY, PRINT CLEARLY.

WATER WELL RECORD
KSA 82a-1201-1215

bdd

Kansas Department of Health and Environment—Division of Environment
(Water well Contractors)
Topeka, Kansas 66620

1. Location of well:	County JACKSON	Fraction 100 1/4 NW 1/4 NW 1/4	Section number 8	Township number T 7 S R 15 EW	Range number
2. Distance and direction from nearest town or city: 1.4 W OF Street address of well location if in city: HOLTON			3. Owner of well: Gus Zibell R.R. or street: R73 City, state, zip code: HOLTON, KS		
4. Locate with "X" in section below: 			6. Bore hole dia. 10 in. Completion date 7-29-77 Well depth 52 ft.		
5. Type and color of material			7. <input checked="" type="checkbox"/> Cable tool <input checked="" type="checkbox"/> Rotary <input type="checkbox"/> Driven <input type="checkbox"/> Dug <input type="checkbox"/> Hollow rod <input type="checkbox"/> Jetted <input type="checkbox"/> Bored <input type="checkbox"/> Reverse rotary		
			8. Use: <input checked="" type="checkbox"/> Domestic <input type="checkbox"/> Public supply <input type="checkbox"/> Industry <input type="checkbox"/> Irrigation <input type="checkbox"/> Air conditioning <input type="checkbox"/> Stock <input type="checkbox"/> Lawn <input type="checkbox"/> Oil field water <input type="checkbox"/> Other		
From To			9. Casing: Material PVC Height: Above or below Threaded <input type="checkbox"/> Welded <input type="checkbox"/> Surface 24 in. RMP PVC 9L Weight 2.58 lbs./ft. Dia. 5 in. to 52 ft. depth Wall Thickness: inches or Dia. <input type="checkbox"/> in. to <input type="checkbox"/> ft. depth gage No. 258		
			10. Screen: Manufacturer's name MPI Type PVC Dia. 5 <input checked="" type="checkbox"/> Slot gauze .020 Length 20 Set between 32 ft. and 52 ft. ft. and <input type="checkbox"/> ft. Gravel pack? <input checked="" type="checkbox"/> Size range of material 1030x1000		
To 0 3			11. Static water level: <input type="checkbox"/> mo./day/yr. 10 ft. below land surface Date 7-29-77		
To 3 37			12. Pumping level below land surfaces: ____ ft. after ____ hrs. pumping ____ g.p.m. ____ ft. after ____ hrs. pumping ____ g.p.m. Estimated maximum yield 30 g.p.m.		
To 37 41			13. Water sample submitted: <input type="checkbox"/> Yes <input checked="" type="checkbox"/> No Date _____		
To 41 52			14. Well head completion: CAP <input type="checkbox"/> Pitless adapter 24 Inches above grade		
			15. Well grouted? <input checked="" type="checkbox"/> With: <input checked="" type="checkbox"/> Neat cement <input type="checkbox"/> Bentonite <input type="checkbox"/> Concrete Depth: From 0 ft. to 10 ft.		
			16. Nearest source of possible contamination: ft. 1000 Direction S Type Creek Well disinfected upon completion? <input checked="" type="checkbox"/> Yes <input type="checkbox"/> No		
			17. Pump: <input checked="" type="checkbox"/> Not installed Manufacturer's name _____ Model number _____ HP _____ Volts _____ Length of drop pipe _____ ft. capacity _____ g.p.m. Type: <input type="checkbox"/> Submersible <input type="checkbox"/> Turbine <input type="checkbox"/> Jet <input type="checkbox"/> Reciprocating <input type="checkbox"/> Centrifugal <input type="checkbox"/> Other		
(Use a second sheet if needed)					
18. Elevation: Topography: <input type="checkbox"/> Hill <input type="checkbox"/> Slope <input type="checkbox"/> Upland <input checked="" type="checkbox"/> Valley	19. Remarks: OWNER TO INSTAL SLAB		20. Water well contractor's certification: This well was drilled under my jurisdiction and this report is true to the best of my knowledge and belief. Strader Day Co Inc 182 Business name License No. Address Holtton, KS Signed Dale Graham Date 7-29-77 Authorized representative		

T 7 L SW 8

Forward the white, blue and pink copies to the Department of Health and Environment

Form WWC-5