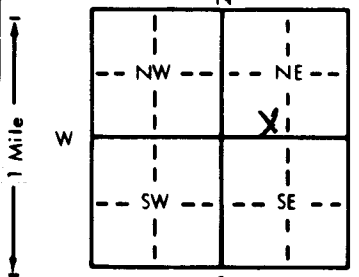


1 LOCATION OF WATER WELL: Fraction SE 1/4 SW 1/4 NE 1/4 Section Number 9 Township Number T 7 S Range Number R 15 EW  
 County: JACKSON  
 Distance and direction from nearest town or city street address of well if located within city?  
200 South Topeka Street

2 WATER WELL OWNER: Steve Morris  
 RR#, St. Address, Box # : 200 S. Topeka Board of Agriculture, Division of Water Resources  
 City, State, ZIP Code : Holton, KS 66436 Application Number:

3 LOCATE WELL'S LOCATION WITH AN "X" IN SECTION BOX:  
  
 4 DEPTH OF COMPLETED WELL: 100 ft. ELEVATION:  
 Depth(s) Groundwater Encountered 1. 30' ft. 2. ft. 3. ft.  
 WELL'S STATIC WATER LEVEL . 22' ft. below land surface measured on mo/day/yr . 8-04-88.  
 Pump test data: Well water was ft. after hours pumping gpm  
 Est. Yield . 2 gpm: Well water was ft. after hours pumping gpm  
 Bore Hole Diameter . 12" in. to ft., and in. to ft.  
 WELL WATER TO BE USED AS:  
 5 Public water supply 8 Air conditioning 11 Injection well  
~~6 Asbestos~~ 3 Feedlot 6 Oil field water supply 9 Dewatering 12 Other (Specify below)  
 2 Irrigation 4 Industrial 7 Lawn and garden only 10 Monitoring well  
 Was a chemical/bacteriological sample submitted to Department? Yes.....No...X.....; If yes, mo/day/yr sample was submitted  
 Water Well Disinfected? Yes X No

5 TYPE OF BLANK CASING USED:  
 1 Steel 3 RMP (SR) 5 Wrought iron 8 Concrete tile CASING JOINTS: Glued . X . Clamped .  
 2 PVC 4 ABS 6 Asbestos-Cement 9 Other (specify below) Welded .  
 7 Fiberglass Threaded .  
 Blank casing diameter . 5" in. to 0-24 ft., Dia . 5" in. to 34-99 ft., Dia . in. to ft.  
 Casing height above land surface . 24" in., weight . 2.82 lbs./ft. Wall thickness or gauge No. . 258  
 TYPE OF SCREEN OR PERFORATION MATERIAL:  
 1 Steel 3 Stainless steel 5 Fiberglass 7 PVC 10 Asbestos-cement  
 2 Brass 4 Galvanized steel 6 Concrete tile 8 RMP (SR) 11 Other (specify)  
 9 ABS 12 None used (open hole)  
 SCREEN OR PERFORATION OPENINGS ARE:  
 1 Continuous slot 3 Mill slot 5 Gauzed wrapped 8 Saw cut 11 None (open hole)  
 2 Louvered shutter 4 Key punched 6 Wire wrapped 9 Drilled holes  
 7 Torch cut 10 Other (specify)  
 SCREEN-PERFORATED INTERVALS: From . 24 ft. to 34 ft., From . ft. to . ft.  
 From . 99 ft. to 100 ft., From . ft. to . ft.  
 GRAVEL PACK INTERVALS: From . 20 ft. to 100 ft., From . ft. to . ft.  
 From . ft. to . ft., From . ft. to . ft.

6 GROUT MATERIAL: 1 Neat cement 2 Cement grout 3 Bentonite 4 Other  
 Grout Intervals: From . 0 ft. to 20 ft., From . ft. to . ft., From . ft. to . ft.  
 What is the nearest source of possible contamination:  
 1 Septic tank 4 Lateral lines 7 Pit privy 10 Livestock pens 14 Abandoned water well  
 2 Sewer lines 5 Cess pool 8 Sewage lagoon 11 Fuel storage 15 Oil well/Gas well  
 3 Watertight sewer lines 6 Seepage pit 9 Feedyard 12 Fertilizer storage 16 Other (specify below)  
 13 Insecticide storage  
 Direction from well? N How many feet? 225

FROM	TO	LITHOLOGIC LOG	FROM	TO	PLUGGING INTERVALS
0	3	Top Soil			
3	10	Clay-Brown			
10	12	Fine Sand-Brown			
12	22	Clay-Brown			
22	27	Fine Sand-Brown			
27	28	Clay-Brown			
28	31	Fine Sand-Coarse Sand-Med-Gravel-Brown			
31	50	Shale-Grey			
50	51	Limestone-Grey			
51	55	Shale-Grey			
55	58	Limestone-Grey			
58	100	Shale-Grey			

7 CONTRACTOR'S OR LANDOWNER'S CERTIFICATION: This water well was (1) constructed, (2) reconstructed, or (3) plugged under my jurisdiction and was completed on (mo/day/year) . August 4, 1988 and this record is true to the best of my knowledge and belief. Kansas Water Well Contractor's License No. . 182 This Water Well Record was completed on (mo/day/yr) . 8-25-88 under the business name of Strader Drilling Co., Inc. by (signature) Dale Strader