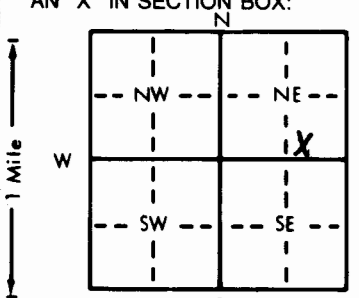


1 LOCATION OF WATER WELL: Fraction SW 1/4 SE 1/4 NE 1/4 Section Number 9 Township Number T 7 S Range Number R 15 E/W
 County: JACKSON

Distance and direction from nearest town or city street address of well if located within city?
404 Magnolia Drive

2 WATER WELL OWNER: ~~Mary Shaw~~ Carrie Shaw
 RR#, St. Address, Box # : 404 Magnolia Drive Board of Agriculture, Division of Water Resources
 City, State, ZIP Code : Holton, KS 66436 Application Number:

3 LOCATE WELL'S LOCATION WITH AN "X" IN SECTION BOX:

 4 DEPTH OF COMPLETED WELL: 90 ft. ELEVATION:
 Depth(s) Groundwater Encountered 1. 18' ft. 2. _____ ft. 3. _____ ft.
 WELL'S STATIC WATER LEVEL 14' ft. below land surface measured on mo/day/yr 8-05-88
 Pump test data: Well water was _____ ft. after _____ hours pumping _____ gpm
 Est. Yield 2 gpm: Well water was _____ ft. after _____ hours pumping _____ gpm
 Bore Hole Diameter 12" in. to _____ ft., and _____ in. to _____ ft.
 WELL WATER TO BE USED AS:
 5 Public water supply 8 Air conditioning 11 Injection well
 1 Domestic 3 Feedlot 6 Oil field water supply 9 Dewatering 12 Other (Specify below)
 2 Irrigation 4 Industrial 7 Lawn and garden only 10 Monitoring well
 Was a chemical/bacteriological sample submitted to Department? Yes _____ No X; If yes, mo/day/yr sample was submitted _____
 Water Well Disinfected? Yes X No

5 TYPE OF BLANK CASING USED:
 1 Steel 3 RMP (SR) 5 Wrought iron 8 Concrete tile CASING JOINTS: Glued X Clamped _____
 2 PVC 4 ABS 6 Asbestos-Cement 9 Other (specify below) Welded _____
 7 Fiberglass Threaded _____
 Blank casing diameter 5" in. to 0-14 ft., Dia 5" in. to 24-89 ft., Dia _____ in. to _____ ft.
 Casing height above land surface 24" in., weight 2.82 lbs./ft. Wall thickness or gauge No. 258
 TYPE OF SCREEN OR PERFORATION MATERIAL:
 1 Steel 3 Stainless steel 5 Fiberglass 7 PVC 8 RMP (SR) 10 Asbestos-cement
 2 Brass 4 Galvanized steel 6 Concrete tile 9 ABS 11 Other (specify) _____
 12 None used (open hole)
 SCREEN OR PERFORATION OPENINGS ARE:
 1 Continuous slot 3 Mill slot 5 Gauzed wrapped 8 Saw cut 11 None (open hole)
 2 Louvered shutter 4 Key punched 6 Wire wrapped 9 Drilled holes
 7 Torch cut 10 Other (specify) _____
 SCREEN-PERFORATED INTERVALS: From 14 ft. to 24 ft., From _____ ft. to _____ ft.
 From 89 ft. to 90 ft., From _____ ft. to _____ ft.
 GRAVEL PACK INTERVALS: From 12 ft. to 90 ft., From _____ ft. to _____ ft.
 From _____ ft. to _____ ft., From _____ ft. to _____ ft.

6 GROUT MATERIAL: 1 Neat cement 2 Cement grout 3 Bentonite 4 Other _____
 Grout Intervals: From 0 ft. to 12 ft., From _____ ft. to _____ ft., From _____ ft. to _____ ft.
 What is the nearest source of possible contamination:
 1 Septic tank 4 Lateral lines 7 Pit privy 10 Livestock pens 14 Abandoned water well
 2 Sewer lines 5 Cess pool 8 Sewage lagoon 11 Fuel storage 15 Oil well/Gas well
 3 Watertight sewer lines 6 Seepage pit 9 Feedyard 12 Fertilizer storage 16 Other (specify below)
 13 Insecticide storage _____
 Direction from well? N How many feet? 75

| FROM | TO | LITHOLOGIC LOG | FROM | TO | PLUGGING INTERVALS |
|------|----|--|------|----|-----------------------------|
| 0 | 2 | Top Soil | | | |
| 2 | 14 | Clay-Brown | | | |
| 14 | 18 | Fine Sand-Coarse Sand-Med-Pea Gravel-Brown | | | 8-15-88 Received permission |
| 18 | 36 | Shale-Grey | | | from Don Taylor to grout |
| 36 | 38 | Limestone-Grey | | | 0-12' |
| 38 | 41 | Shale-Red | | | |
| 41 | 45 | Limestone-Grey | | | |
| 45 | 88 | Shale-Grey | | | |
| 88 | 90 | Limestone-Grey | | | |

7 CONTRACTOR'S OR LANDOWNER'S CERTIFICATION: This water well was (1) constructed, (2) reconstructed, or (3) plugged under my jurisdiction and was completed on (mo/day/year) 8-05-88 and this record is true to the best of my knowledge and belief. Kansas Water Well Contractor's License No. 182 This Water Well Record was completed on (mo/day/yr) 8-25-88 under the business name of Strader Drilling Co., Inc. by (signature) Debb Jackson

OFFICE USE ONLY
T
R
EW
SEC
1/4
1/4
1/4