


1 LOCATION OF WATER WELL: Fraction SW 1/4 NW 1/4 SE 1/4 Section Number 9 Township Number T 17 S Range Number R 15 E/W

Distance and direction from nearest town or city street address of well if located within city? City limits of Holton

2 WATER WELL OWNER: City of Holton N.E. Well @ Swimming Pool Board of Agriculture, Division of Water Resources
 RR#, St. Address, Box #: Holton, KS 66436 Application Number: 38389
 City, State, ZIP Code: _____

3 LOCATE WELL'S LOCATION WITH AN "X" IN SECTION BOX:

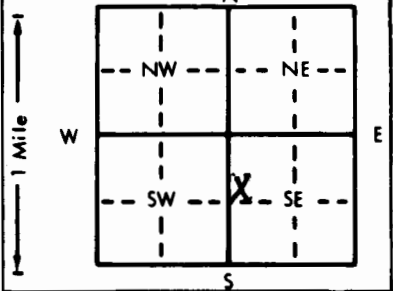

4 DEPTH OF COMPLETED WELL: 55 ft. ELEVATION: _____

Depth(s) Groundwater Encountered 1. _____ ft. 2. _____ ft. 3. _____ ft.

WELL'S STATIC WATER LEVEL: 15 ft. below land surface measured on mo/day/yr 9-03-86

Pump test data: Well water was _____ ft. after _____ hours pumping _____ gpm

Est. Yield 20 gpm: Well water was _____ ft. after _____ hours pumping _____ gpm

Bore Hole Diameter: 12 in. to _____ ft., and _____ in. to _____ ft.

WELL WATER TO BE USED AS: 5 Public water supply 8 Air conditioning 11 Injection well
 1 Domestic 3 Feedlot 6 Oil field water supply 9 Dewatering 12 Other (Specify below)

2 Irrigation 4 Industrial 7 Lawn and garden only 10 Observation well Permanent monitor

Was a chemical/bacteriological sample submitted to Department? Yes _____ No X; If yes, mo/day/yr sample was submitted

Water Well Disinfected? Yes X No

5 TYPE OF BLANK CASING USED: 5 Wrought iron 8 Concrete tile CASING JOINTS: Glued X Clamped _____

1 Steel 3 RMP (SR) 6 Asbestos-Cement 9 Other (specify below) Welded _____

2 PVC 4 ABS 7 Fiberglass _____ Threaded _____

Blank casing diameter 5 in. to 0-15 ft., Dia _____ in. to _____ ft., Dia _____ in. to _____ ft.

Casing height above land surface 24 in., weight 2.82 lbs./ft. Wall thickness or gauge No. 258

TYPE OF SCREEN OR PERFORATION MATERIAL: 7 PVC 10 Asbestos-cement

1 Steel 3 Stainless steel 5 Fiberglass 8 RMP (SR) 11 Other (specify) _____

2 Brass 4 Galvanized steel 6 Concrete tile 9 ABS 12 None used (open hole)

SCREEN OR PERFORATION OPENINGS ARE: 5 Gauzed wrapped 8 Saw cut 11 None (open hole)

1 Continuous slot 3 Mill slot 6 Wire wrapped 9 Drilled holes

2 Louvered shutter 4 Key punched 7 Torch cut 10 Other (specify) _____

SCREEN-PERFORATED INTERVALS: From 15 ft. to 55 ft., From _____ ft. to _____ ft.

GRAVEL PACK INTERVALS: From 10 ft. to 55 ft., From _____ ft. to _____ ft.

6 GROUT MATERIAL: 1 Neat cement 2 Cement grout 3 Bentonite 4 Other _____

Grout Intervals: From 0 ft. to 10 ft., From _____ ft. to _____ ft., From _____ ft. to _____ ft.

What is the nearest source of possible contamination: 10 Livestock pens 14 Abandoned water well

1 Septic tank 4 Lateral lines 7 Pit privy 11 Fuel storage 15 Oil well/Gas well

2 Sewer lines 5 Cess pool 8 Sewage lagoon 12 Fertilizer storage 16 Other (specify below)

3 Watertight sewer lines 6 Seepage pit 9 Feedyard 13 Insecticide storage

Direction from well? W How many feet? 130

FROM	TO	LITHOLOGIC LOG	FROM	TO	LITHOLOGIC LOG
0	15	Clay-Brown-Silty			
15	26	Fine Sand-Coarse Sand-Med-Pea	1/4x1/2		Brown-Clean
26	30	Clay-Blue			
30	40	Shale-Green-Soft			
40	50	Sandstone-Green			
50	60	Shale-Grey			

7 CONTRACTOR'S OR LANDOWNER'S CERTIFICATION: This water well was (1) constructed, (2) reconstructed, or (3) plugged under my jurisdiction and was completed on (mo/day/year) 9-03-86 and this record is true to the best of my knowledge and belief. Kansas Water Well Contractor's License No. 182 This Water Well Record was completed on (mo/day/yr) 10-21-86 under the business name of Strader Drilling Co., Inc. by (signature) Dale W. Strader