


1 LOCATION OF WATER WELL: County: ~~Nebraska~~ Jackson SW 1/4 SE 1/4 SW 1/4 Section Number 3 Township Number T 7 S Range Number R 15 (EW)
 Distance and direction from nearest town or city street address of well if located within city? 115 E. 5th, Holton, KS

2 WATER WELL OWNER: Kent's Care RR#, St. Address, Box #: 115 E. 5th City, State, ZIP Code: Holton, KS Board of Agriculture, Division of Water Resources Application Number: MW19

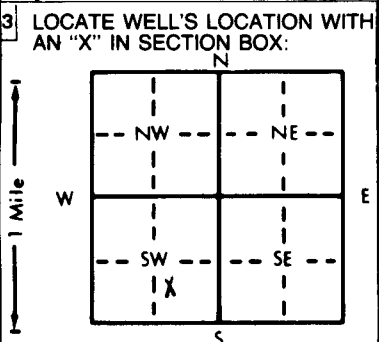

4 DEPTH OF COMPLETED WELL: 25 ft. ELEVATION: ... ft.
 Depth(s) Groundwater Encountered 1. ... ft. 2. ... ft. 3. ... ft.
 WELL'S STATIC WATER LEVEL ... ft. below land surface measured on mo/day/yr
 Pump test data: Well water was ... ft. after ... hours pumping ... gpm
 Est. Yield ... gpm; Well water was ... ft. after ... hours pumping ... gpm
 Bore Hole Diameter: 8 1/2 in. to 25 ft. and ... in. to ... ft.
 WELL WATER TO BE USED AS: 5 Public water supply 8 Air conditioning 11 Injection well
 1 Domestic 3 Feedlot 6 Oil field water supply 9 Dewatering 12 Other (Specify below)
 2 Irrigation 4 Industrial 7 Lawn and garden only 10 Monitoring well
 Was a chemical/bacteriological sample submitted to Department? Yes ... No ; If yes, mo/day/yr sample was submitted
 Water Well Disinfected? Yes No

5 TYPE OF BLANK CASING USED: 1 Steel 3 RMP (SR) 5 Wrought iron 8 Concrete tile CASING JOINTS: Glued ... Clamped ...
 PVC 4 ABS 7 Fiberglass 9 Other (specify below) Welded ...
 Blank casing diameter ... in. to ... ft., Dia ... in. to ... ft., Dia ... in. to ... ft.
 Casing height above land surface ... in., weight ... lbs./ft. Wall thickness or gauge No. ...
 TYPE OF SCREEN OR PERFORATION MATERIAL: 1 Steel 3 Stainless steel 5 Fiberglass 8 RMP (SR) 10 Asbestos-cement
 2 Brass 4 Galvanized steel 6 Concrete tile 9 ABS 11 Other (specify) ...
 SCREEN OR PERFORATION OPENINGS ARE: 1 Continuous slot 3 Mill slot 5 Gauzed wrapped 8 Saw cut 11 None (open hole)
 2 Louvered shutter 4 Key punched 6 Wire wrapped 9 Drilled holes 10 Other (specify) ...
 SCREEN-PERFORATED INTERVALS: From 25 ft. to 8 ft. From ... ft. to ... ft.
 GRAVEL PACK INTERVALS: From 25 ft. to 6 ft. From ... ft. to ... ft.

6 GROUT MATERIAL: Neat cement 2 Cement grout 3 Bentonite 4 Other
 Grout Intervals: From 6 ft. to ... ft. From ... ft. to ... ft. From ... ft. to ... ft.
 What is the nearest source of possible contamination: 1 Septic tank 4 Lateral lines 7 Pit privy 10 Livestock pens 14 Abandoned water well
 2 Sewer lines 5 Cess pool 8 Sewage lagoon 11 Fuel storage 15 Oil well/Gas well
 3 Watertight sewer lines 6 Seepage pit 9 Feedyard 12 Fertilizer storage 16 Other (specify below)
 13 Insecticide storage
 Direction from well? East from MW10 How many feet? 100

FROM	TO	LITHOLOGIC LOG	FROM	TO	PLUGGING INTERVALS
0	1'	Gravels			
1'	5'	Dark brown silty clay, wet, firm			
5'	13'	Brown silty clay, wet, firm			
13'	25'	Brown medium sand loose			

RECEIVED BY [Signature] DATE 2/21/01

7 CONTRACTOR'S OR LANDOWNER'S CERTIFICATION: This water well was (1) constructed, (2) reconstructed, or (3) plugged under my jurisdiction and was completed on (mo/day/year) 2-25-01 and this record is true to the best of my knowledge and belief. Kansas Water Well Contractor's License No. 634 This Water Well Record was completed on (mo/day/year) 2-20-01 under the business name of Shulz EWI Tesky by (signature) [Signature]