

**WATER WELL PLUGGING RECORD Form WWC-5P**

KSA 82a-1212 ID NO.

MW-15


|  |   |                            |                             |                                     |
|--|---|----------------------------|-----------------------------|-------------------------------------|
| <b>1 LOCATION OF WATER WELL:</b><br>County: <u>Jackson</u> | Fraction<br><u>SW 1/4 SE 1/4 SW 1/4</u> | Section Number<br><u>3</u> | Township Number<br><u>7</u> | Range Number<br><u>15</u> <u>EW</u> |
|--|---|----------------------------|-----------------------------|-------------------------------------|

Distance and direction from nearest town or city street address of well if located within city?

115 E 5th St, Holton, KS

|   |   |  |
|---|---|--|
| <b>2 WATER WELL OWNER:</b><br>RR#, St. Address, Box #:<br>City, State ZIP Code: | <u>Ken's Korner</u><br><u>115 E 5th St</u><br><u>Holton, KS 66436</u> | <b>Global Positioning Systems</b> (decimal degrees, min. of 4 digits)<br>Latitude: <u>N 39.46453°</u><br>Longitude: <u>W 95.73339°</u><br>Elevation: _____<br>Datum: _____<br>Data Collection Method: <u>Garmin Nuvi 750</u> |
|---|---|--|

|   |  |
|---|--|
| <b>3 MARK WELL'S LOCATION WITH AN "X" IN SECTION BOX:</b> | <b>4 DEPTH OF WELL</b> <u>41.70</u> ft.<br>WELL'S STATIC WATER LEVEL <u>27.24</u> ft.<br>WELL WAS USED AS:<br>1 Domestic                      5 Public Water Supply                      9 Dewatering<br>2 Irrigation                      6 Oil Field Water Supply                      10 Monitoring<br>3 Feedlot                      7 Domestic (Lawn & Garden)                      11 Injection Well<br>4 Industrial                      8 Air Conditioning                      12 Other _____<br>Was a chemical/bacteriological sample submitted to Department? Yes _____ No <u>X</u> |
|---|--|

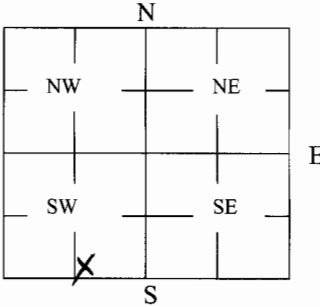

**5 TYPE OF BLANK CASING USED:**

|              |            |                   |                 |                         |
|--------------|------------|-------------------|-----------------|-------------------------|
| 1 Steel      | 3 RMP (SR) | 5 Wrought         | 7 Fiberglass    | 9 Other (Specify below) |
| <u>2</u> PVC | 4 ABS      | 6 Asbestos-Cement | 8 Concrete Tile |                         |

Blank casing diameter 2 in. Was casing pulled? Yes X No \_\_\_\_\_ If yes, how much 20 ft  
Casing height above or below land surface 240 in.

**6 GROUT PLUG MATERIAL:** 1 Neat cement    2 Cement grout    3 Bentonite    4 Other \_\_\_\_\_

Grout Plug Intervals: From 41.7 ft. to 0 ft., From \_\_\_\_\_ ft. to \_\_\_\_\_ ft., From \_\_\_\_\_ to \_\_\_\_\_ ft.

What is the nearest source of possible contamination:

|                          |                   |                         |                               |
|--------------------------|-------------------|-------------------------|-------------------------------|
| 1 Septic tank            | 6 Seepage pit     | <u>11</u> Fuel Storage  | 16 Other (specify below)      |
| 2 Sewer lines            | 7 Pit privy       | 12 Fertilizer storage   |                               |
| 3 Watertight sewer lines | 8 Sewage lagoon   | 13 Insecticide storage  |                               |
| 4 Lateral lines          | 9 Feedyard        | 14 Abandoned water well | Direction from well? <u>W</u> |
| 5 Cess pool              | 10 Livestock pens | 15 Oil well/Gas well    | How many feet? <u>5</u>       |

| FROM     | TO          | PLUGGING MATERIALS        | FROM | TO | PLUGGING MATERIALS |
|----------|-------------|---------------------------|------|----|--------------------|
| <u>0</u> | <u>41.7</u> | <u>hydrated bentonite</u> |      |    |                    |
|          |             |                           |      |    |                    |
|          |             |                           |      |    |                    |
|          |             |                           |      |    |                    |
|          |             |                           |      |    |                    |

**7 CONTRACTOR'S OR LANDOWNER'S CERTIFICATION:** This water well was plugged under my jurisdiction and was completed on (mo/day/year) 06/28/2010 and this record is true to the best of my knowledge and belief. Kansas Water Well Contractor's License No. \_\_\_\_\_. This Water Well Record was completed on (mo/day/year) \_\_\_\_\_ under the business name of Terranext, LLC by (signature) Matthew P. Water

**INSTRUCTIONS:** Use typewriter or ballpoint pen. Please press firmly and print clearly. Please fill in blanks, underline or circle the correct answers. Send top three copies to Kansas Department of Health and Environment, Bureau of Water, Geology Section, 1000 SW Jackson St., Ste. 420, Topeka, Kansas 66612-1367. Telephone: 785/296-5522. Send one to Water Well Owner and retain one for your records. Visit us at <http://www.kdheks.gov/geo/waterwells>.