


MV4

☒ Original Record ☐ Correction ☐ Change in Well Use

Well ID

[illegible]

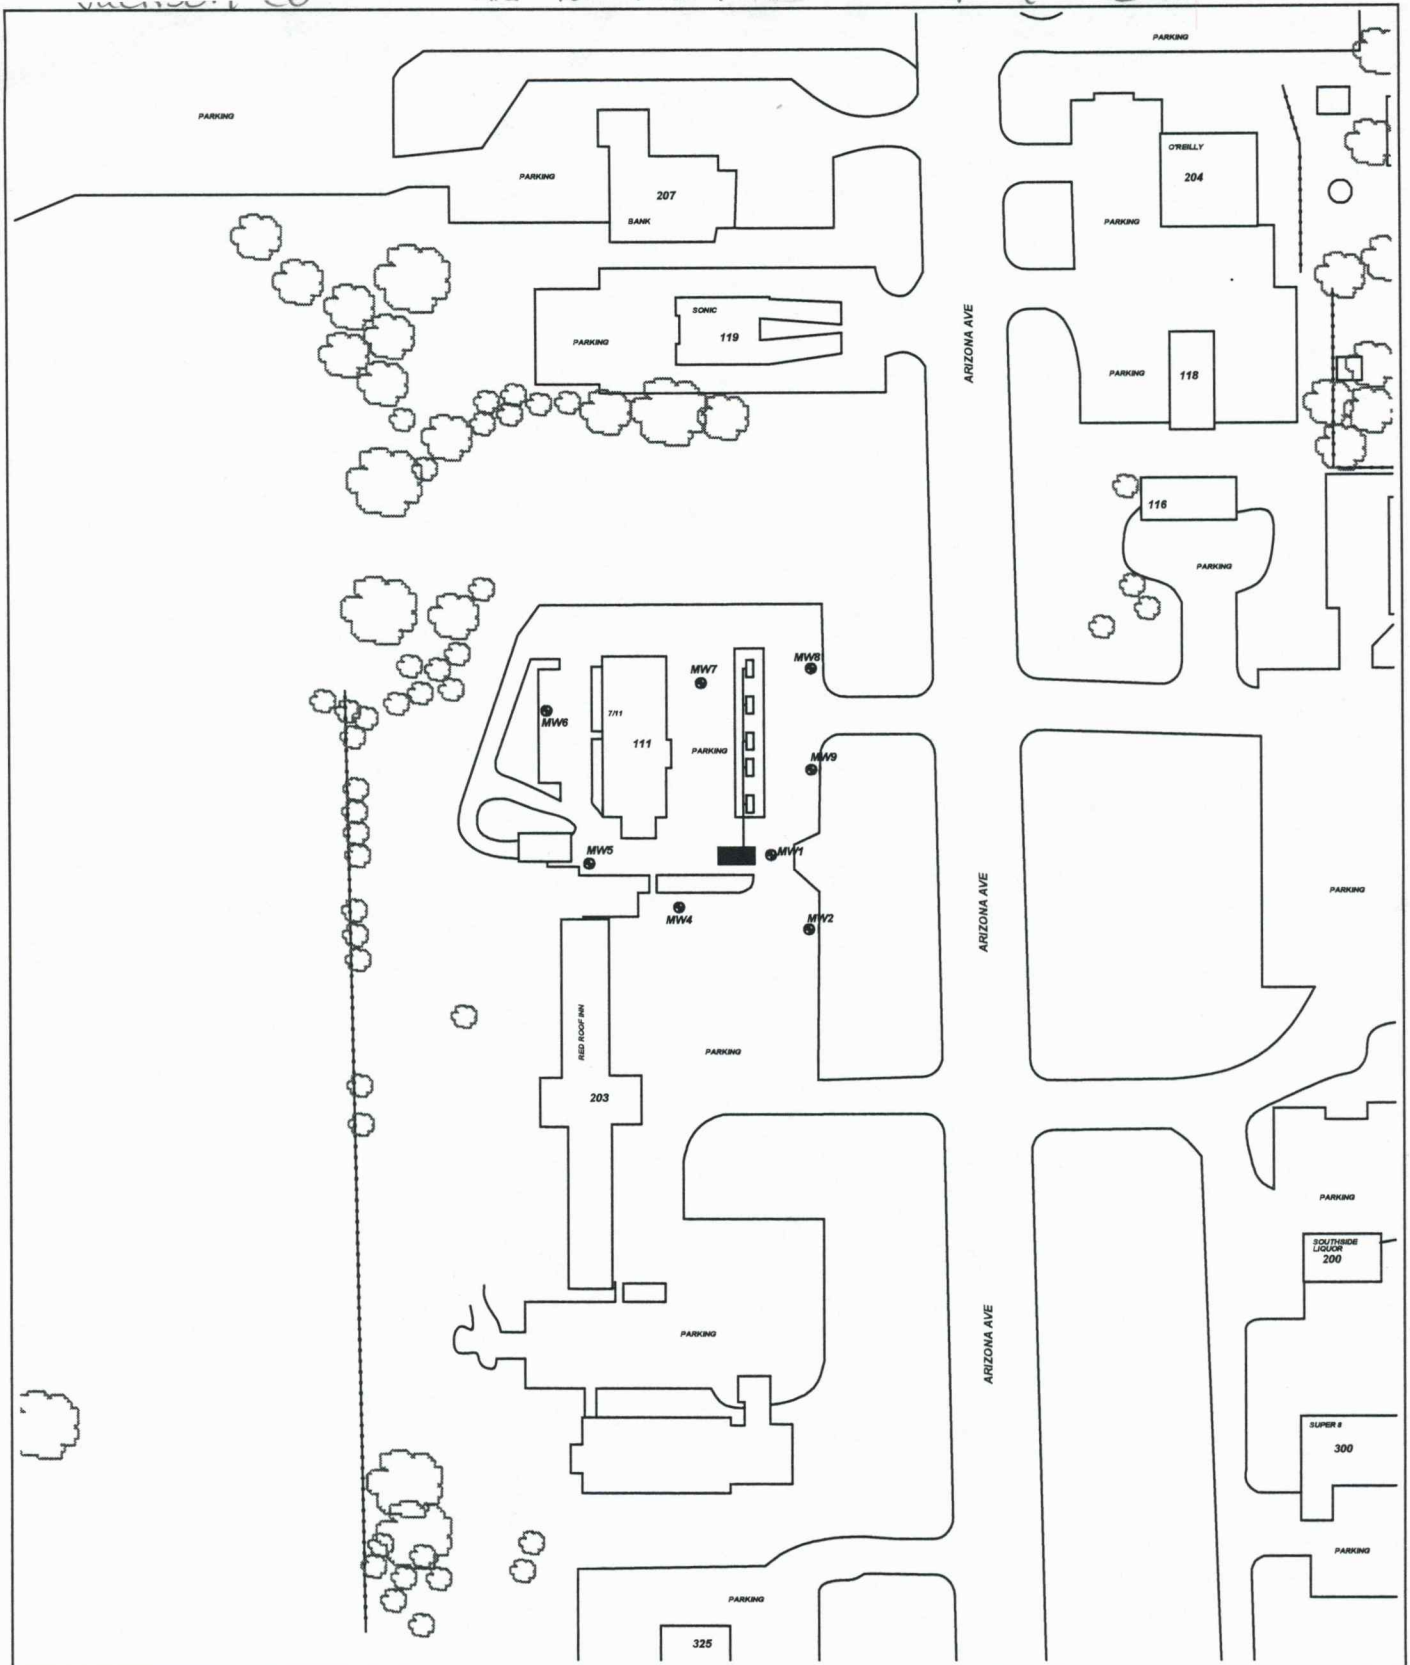

PROJECT: 7/11/STAR FUEL #606

ADDRESS: 111 S. 75 HWY


LOCATION: HOLTON, KS

DRAWN BY: C. ROE DATE: 11/6/19

REVISED BY: C. ROE DATE: 3/19/20

AEI JOB #: TF522 KDHE JOB #: U4-043-15166

SCALE: 1" = 100'

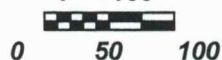

NOTES:

TITLE:



ASSOCIATED
ENVIRONMENTAL
INC.

LEGEND:

= UST BASIN AND PUMP ISLANDS

= MONITORING WELL

..... = SUBJECT PROPERTY

