

WATER WELL PLUGGING RECORD Form WWC-5P

KSA 82a-1212

ID NO.

MW9


1 LOCATION OF WATER WELL: Fraction NE 1/4 NE 1/4 SE 1/4 NW 1/4 Section Number 9 Township Number T 7 S Range Number 15 E W
 County: JACKSON

Street/Rural Address of Well Location; if unknown, distance & direction from nearest town or intersection: If at owner's address, check here 111 S. 75 HWY HOLTON, KS

Global Positioning Systems (GPS) information:
 Latitude: 39.45921 (in decimal degrees)
 Longitude: 95.74840 (in decimal degrees)
 Elevation: 1060.06
 Horizontal Datum: WGS84, NAD83, NAD27
 Collection Method:

2 WATER WELL OWNER: JERRY ROUSH
 RR#, St. Address, Box #: 7415 W. 130TH ST., SUITE 100
 City, State ZIP Code: OVERLAND PARK, KS 66213

GPS unit (Make/Model: _____)
 Digital Map/Photo, Topographic Map, Land Survey
 Est. Accuracy: < 3 m, 3-5 m, 5-15 m, > 15 m

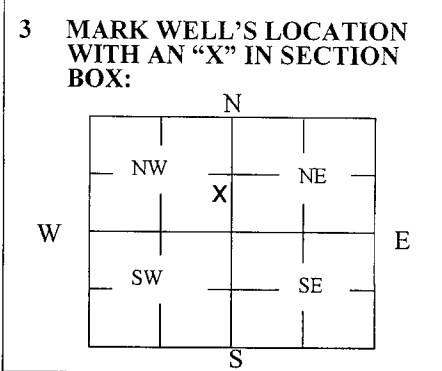

4 DEPTH OF WELL 19.25 ft.
 WELL'S STATIC WATER LEVEL 9.75 ft.
 WELL WAS USED AS:
 Domestic Public Water Supply Dewatering
 Irrigation Oil Field Water Supply Monitoring
 Feedlot Domestic (Lawn & Garden) Injection Well
 Industrial Air Conditioning Other _____
 Was a chemical/bacteriological sample submitted to Department? Yes No

5 TYPE OF BLANK CASING USED:

Steel RMP (SR) Wrought Fiberglass Other (Specify below) _____
 PVC ABS Asbestos-Cement Concrete Tile

Blank casing diameter 2 in. Was casing pulled? Yes No If yes, how much 3'
 Casing height above or below land surface 0 in.

6 GROUT PLUG MATERIAL: Neat cement Cement grout Bentonite Other CONCRETE 0-0.5


Grout Plug Intervals: From 0.5 ft. to 19.25 ft., From _____ ft. to _____ ft., From _____ ft. to _____ ft.

What is the nearest source of possible contamination:
 Septic tank Seepage pit Fuel storage Other (specify below) _____
 Sewer lines Pit privy Fertilizer storage _____
 Watertight sewer lines Sewage lagoon Insecticide storage _____
 Lateral lines Feedyard Abandoned water well Oil well/Gas well Direction from well? SOUTH
 Cess pool Livestock pens How many feet? 70

FROM	TO	PLUGGING MATERIALS	FROM	TO	PLUGGING MATERIALS
0	0.5	CONCRETE			
0.5	19.25	BENTONITE			

7 CONTRACTOR'S OR LANDOWNER'S CERTIFICATION: This water well was plugged under my jurisdiction and was completed on (mo/day/year) 7/7/22 and this record is true to the best of my knowledge and belief. Kansas Water Well Contractor's License No. 585. This Water Well Record was completed on (mo/day/year) 7/8/22 under the business name of ASSOCIATED ENVIRONMENTAL INC. by (signature) _____

Send one white copy to Kansas Department of Health & Environment, Geology Section, 1000 SW Jackson Street, Ste. 420, Topeka, KS 66612-1367. Send one copy to WATER WELL OWNER and retain one for your records.
 Visit us at <http://www.kdheks.gov/waterwell/index.html> Telephone 785-296-5524.

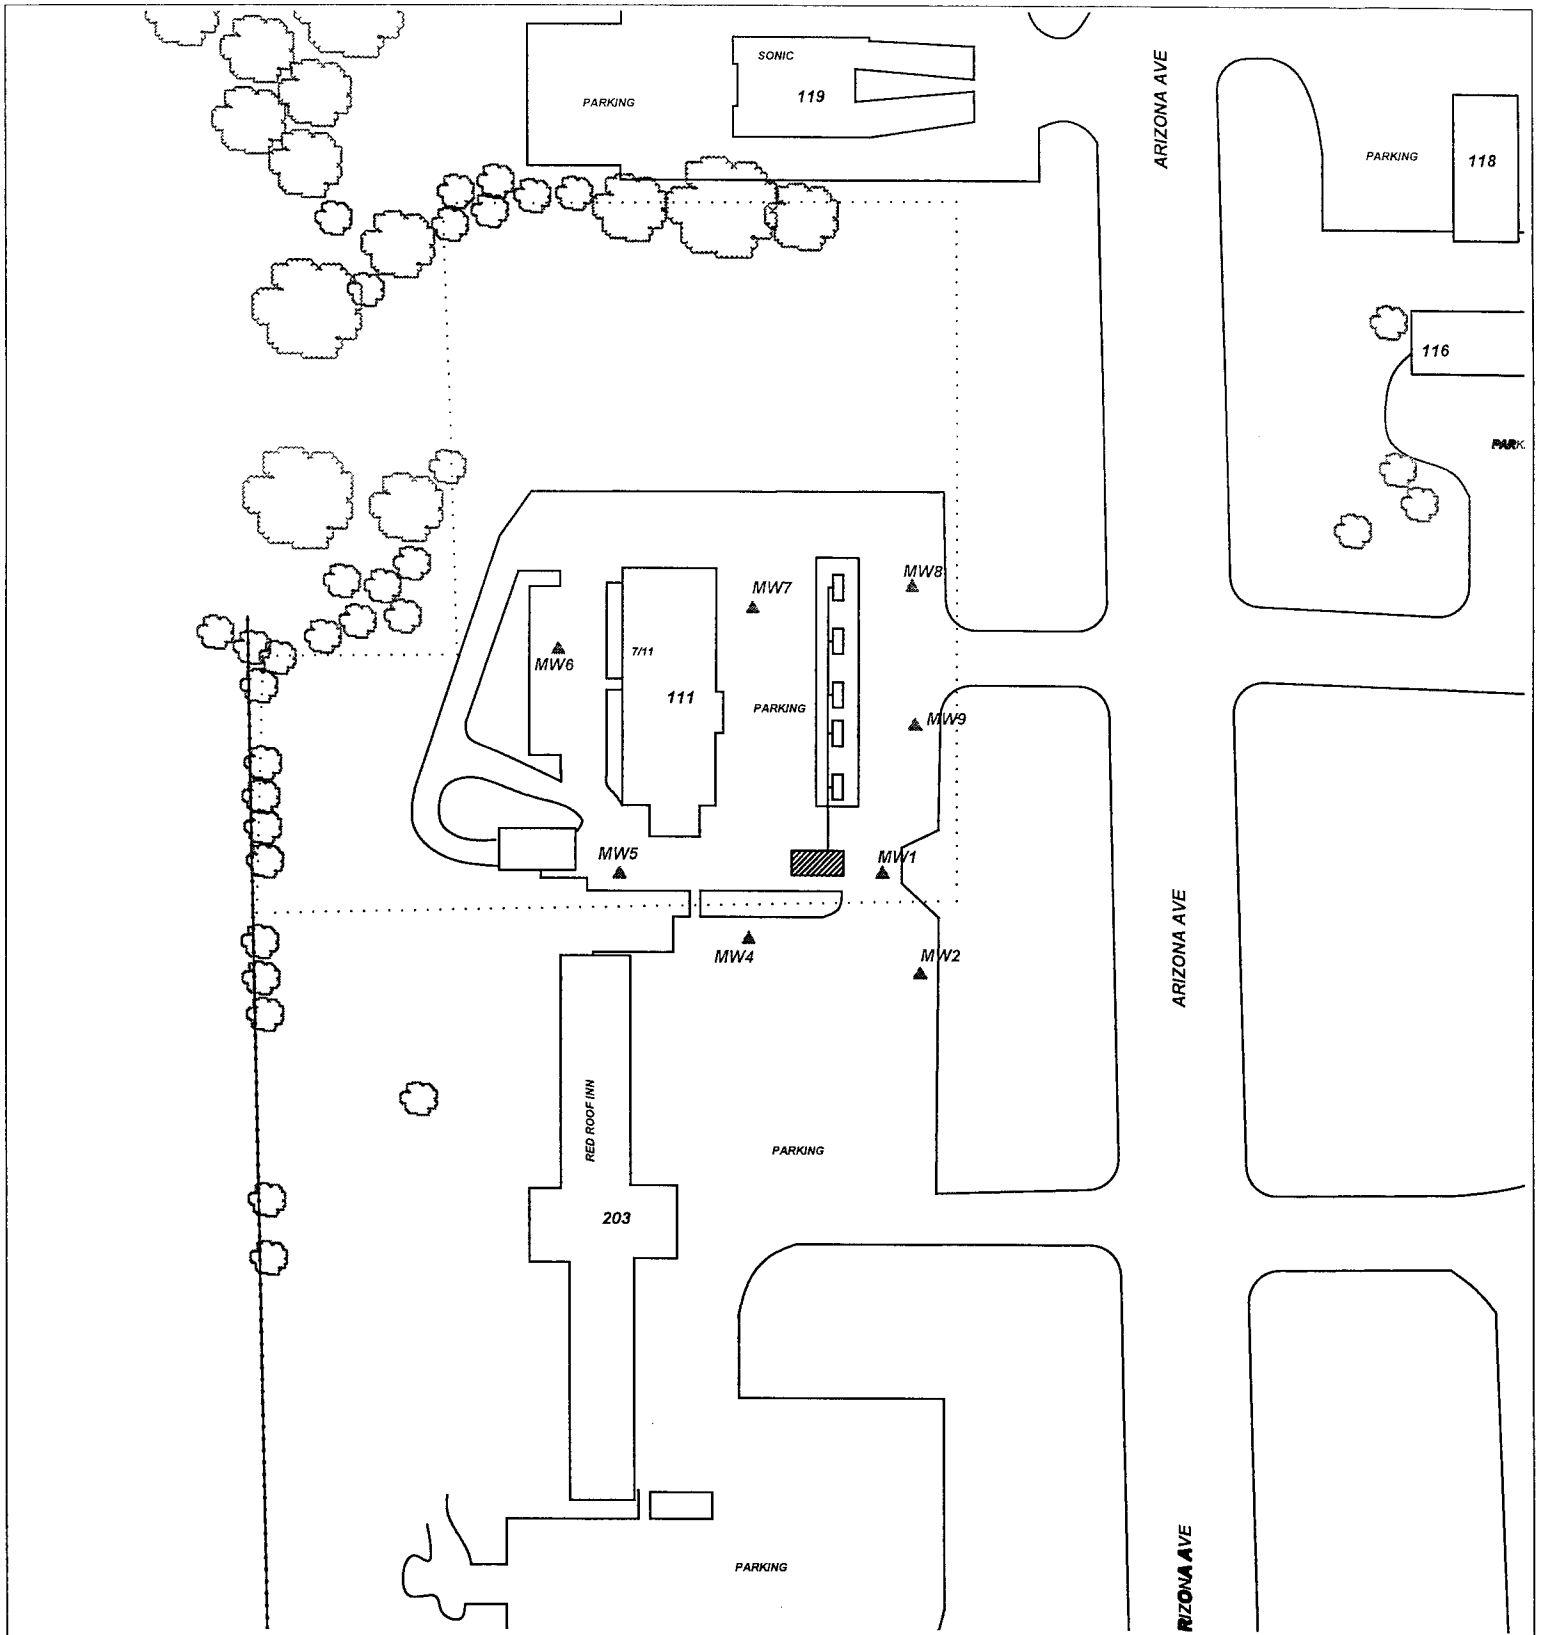

PROJECT: **7/11/STAR FUEL #606**

ADDRESS: **111 S. 75 HWY**

LOCATION: **HOLTON, KS**

DRAWN BY: **C. ROE** DATE: **11/6/19**

REVISED BY: **B. STALNAKER** DATE: **7/7/22**

AEI JOB #: **TF522** KDHE JOB #: **U4-043-15166**

TITLE:

ASSOCIATED ENVIRONMENTAL INC.

LEGEND:

- = UST BASIN AND PUMP ISLANDS
- = MONITORING WELL
- = SUBJECT PROPERTY

SCALE: **1" = 100'**

NOTES: