

**WATER WELL PLUGGING RECORD Form WWC-5P** KSA 82a-1212 ID NO.

MW1


**1 LOCATION OF WATER WELL:** Fraction NE 1/4 NE 1/4 SE 1/4 NW 1/4 Section Number 9 Township Number T 7 S Range Number 15  E  W  
 County: JACKSON

Street/Rural Address of Well Location; if unknown, distance & direction from nearest town or intersection: If at owner's address, check here  111 S. 75 HWY HOLTON, KS

**Global Positioning Systems (GPS) information:**  
 Latitude: 39.45904 (in decimal degrees)  
 Longitude: 95.74847 (in decimal degrees)  
 Elevation: 1061.09  
 Horizontal Datum:  WGS84,  NAD83,  NAD27  
 Collection Method:

**2 WATER WELL OWNER:** JERRY ROUSH  
 RR#, St. Address, Box #: 7415 W. 130TH ST., SUITE 100  
 City, State ZIP Code: OVERLAND PARK, KS 66213

GPS unit (Make/Model: \_\_\_\_\_)  
 Digital Map/Photo,  Topographic Map,  Land Survey  
 Est. Accuracy:  < 3 m,  3-5 m,  5-15 m,  > 15 m

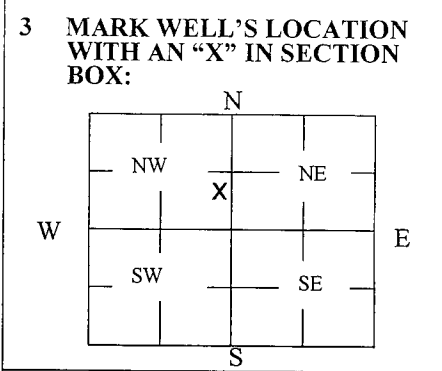

**4 DEPTH OF WELL** 18013 ft. 18.13 (kgsdr1)  
 WELL'S STATIC WATER LEVEL 10.98 ft  
 WELL WAS USED AS:  
 Domestic Irrigation  Public Water Supply  Dewatering  
 Feedlot  Oil Field Water Supply  Monitoring  
 Industrial  Domestic (Lawn & Garden)  Injection Well  
 Air Conditioning  
 Was a chemical/bacteriological sample submitted to Department? Yes  No

**5 TYPE OF BLANK CASING USED:**

Steel  RMP (SR)  Wrought  Fiberglass  Other (Specify below)  
 PVC  ABS  Asbestos-Cement  Concrete Tile

Blank casing diameter 2 in. Was casing pulled? Yes  No  If yes, how much 3'  
 Casing height above or below land surface 0 in.

**6 GROUT PLUG MATERIAL:**  Neat cement  Cement grout  Bentonite  Other CONCRETE 0-0.5

Grout Plug Intervals: From 0.5 ft. to 18.13 ft., From \_\_\_\_\_ ft. to \_\_\_\_\_ ft., From \_\_\_\_\_ ft. to \_\_\_\_\_ ft.

What is the nearest source of possible contamination:


Septic tank  Seepage pit  Fuel storage  Other (specify below)  
 Sewer lines  Pit privy  Fertilizer storage  
 Watertight sewer lines  Sewage lagoon  Insecticide storage  
 Lateral lines  Feedyard  Abandoned water well  
 Cess pool  Livestock pens  Oil well/Gas well

Direction from well? WEST  
 How many feet? 15

FROM	TO	PLUGGING MATERIALS	FROM	TO	PLUGGING MATERIALS
0	0.5	CONCRETE			
0.5	18.13	BENTONITE			

**7 CONTRACTOR'S OR LANDOWNER'S CERTIFICATION:** This water well was plugged under my jurisdiction and was completed on (mo/day/year) 7/7/22 and this record is true to the best of my knowledge and belief. Kansas Water Well Contractor's License No. 585. This Water Well Record was completed on (mo/day/year) 7/22 under the business name of ASSOCIATED ENVIRONMENTAL INC. by (signature) [Signature]

Send one white copy to Kansas Department of Health & Environment, Geology Section, 1000 SW Jackson Street, Ste. 420, Topeka, KS 66612-1367. Send one copy to WATER WELL OWNER and retain one for your records.  
 Visit us at <http://www.kdheks.gov/waterwell/index.html> Telephone 785-296-5524.

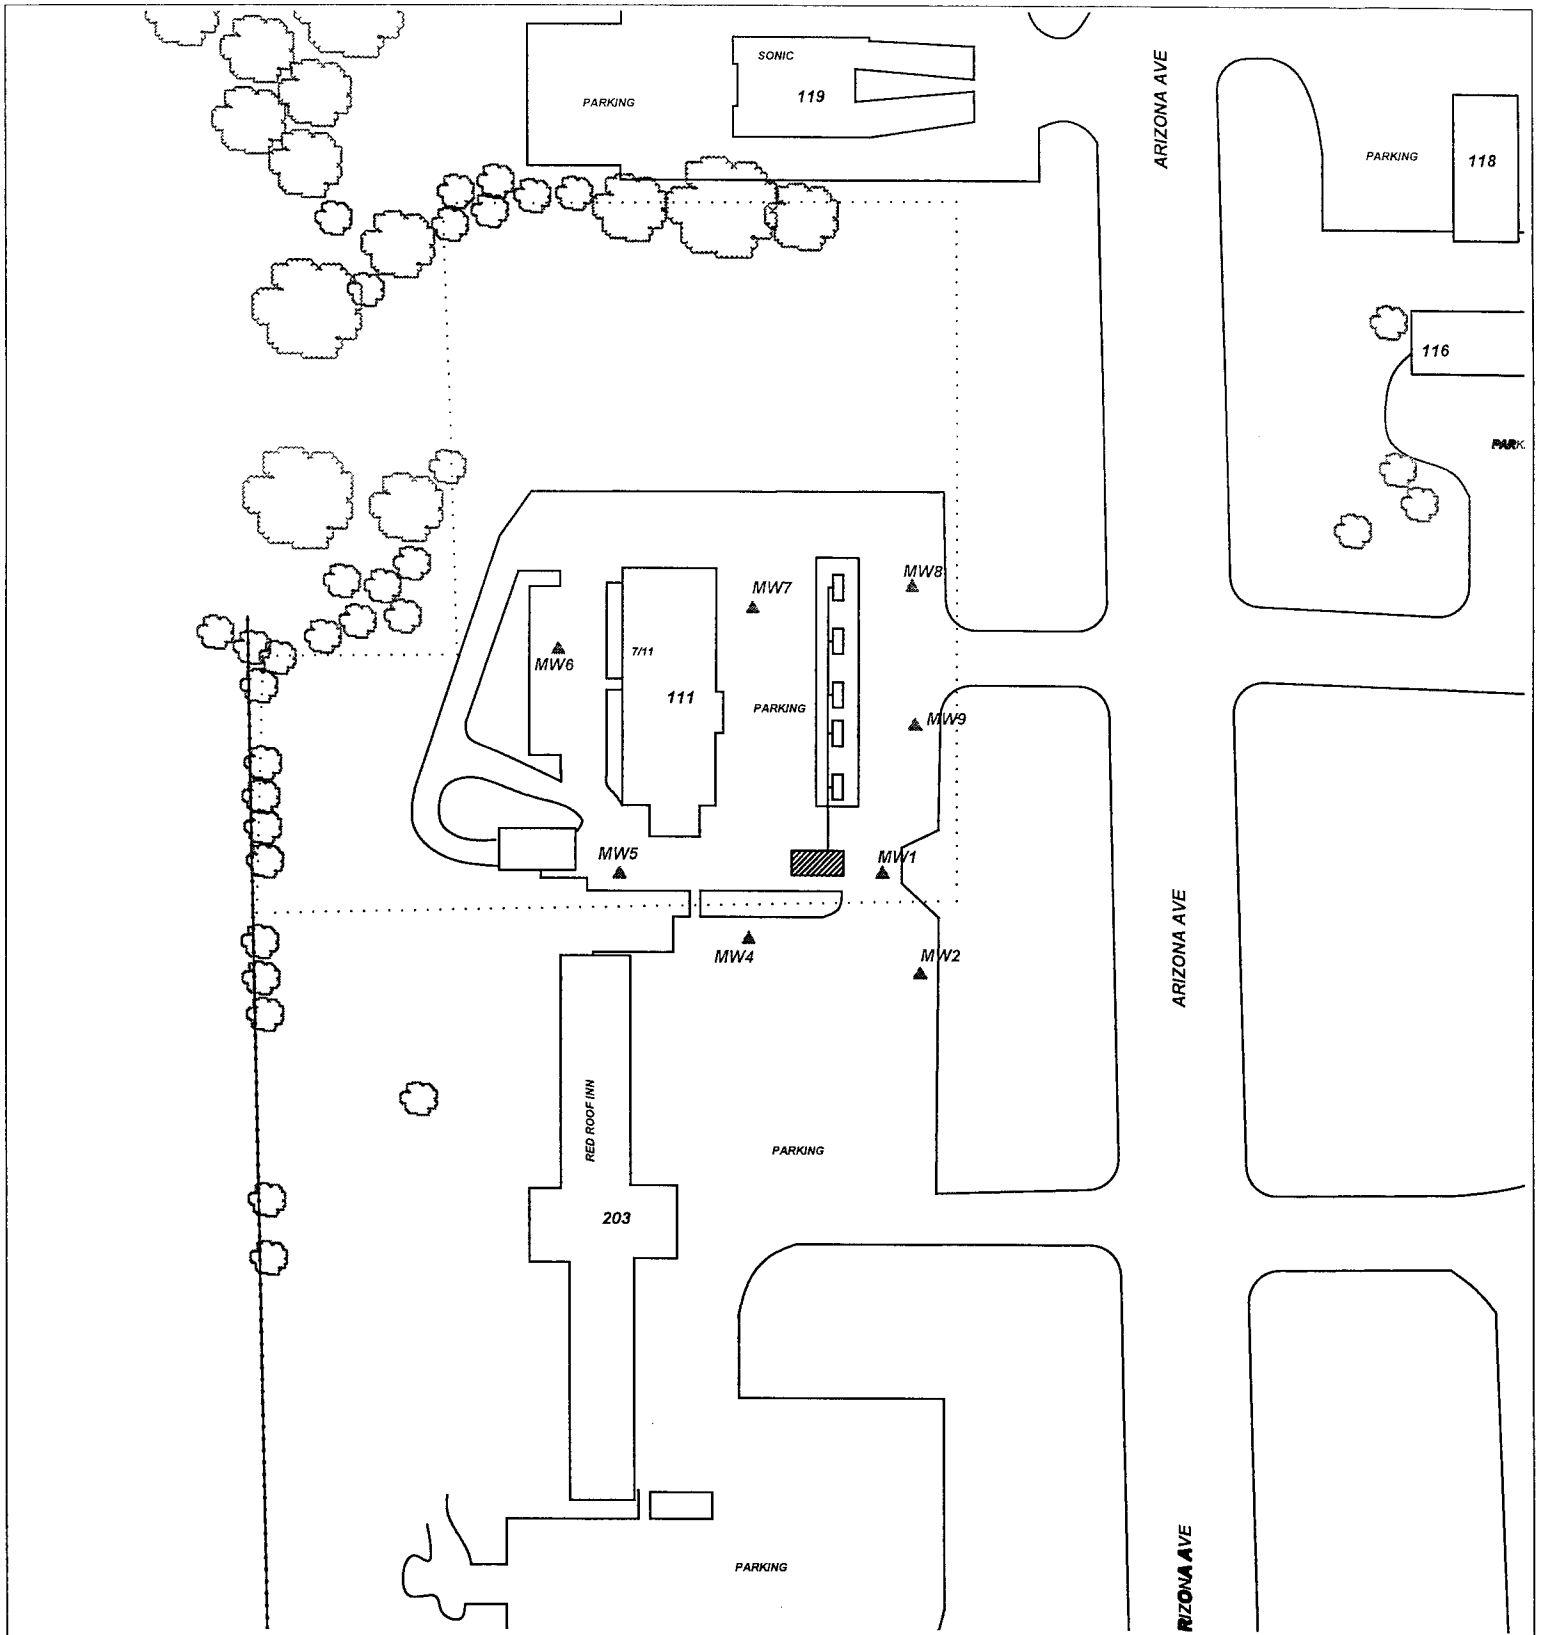

PROJECT: **7/11/STAR FUEL #606**

ADDRESS: **111 S. 75 HWY**

LOCATION: **HOLTON, KS**

DRAWN BY: **C. ROE** DATE: **11/6/19**

REVISED BY: **B. STALNAKER** DATE: **7/7/22**

AEI JOB #: **TF522** KDHE JOB #: **U4-043-15166**

TITLE:

**ASSOCIATED ENVIRONMENTAL INC.**

LEGEND:

= UST BASIN AND PUMP ISLANDS

= MONITORING WELL

= SUBJECT PROPERTY

SCALE: **1" = 100'**

NOTES: