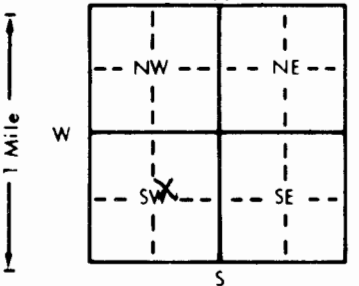


WATER WELL RECORD Form WWC-5 KSA 82a-1212

1 LOCATION OF WATER WELL: County: **JACKSON** Fraction: **SW 1/4 NE 1/4 SW 1/4** Section Number: **3** Township Number: **T 7 S** Range Number: **R 15 BW**

Distance and direction from nearest town or city street address of well if located within city?
2th & OHIO **MW #8**

2 WATER WELL OWNER: **CITY OF HOLTON**
 RR#, St. Address, Box #: **416 PENN AVE** Board of Agriculture, Division of Water Resources
 City, State, ZIP Code: **HOLTON, KS 66436** Application Number:

3 LOCATE WELL'S LOCATION WITH AN "X" IN SECTION BOX:

 4 DEPTH OF COMPLETED WELL: **15** ft. ELEVATION: **1055.20**
 Depth(s) Groundwater Encountered: 1. **1.5** ft. 2. _____ ft. 3. _____ ft.
 WELL'S STATIC WATER LEVEL: **1.5** ft. below land surface measured on mo/day/yr: **8/5/74**
 Pump test data: Well water was _____ ft. after _____ hours pumping _____ gpm
 Est. Yield _____ gpm: Well water was _____ ft. after _____ hours pumping _____ gpm
 Bore Hole Diameter: _____ in. to _____ ft., and _____ in. to _____ ft.
 WELL WATER TO BE USED AS:
 1 Domestic 3 Feedlot 6 Oil field water supply 8 Air conditioning 11 Injection well
 2 Irrigation 4 Industrial 7 Lawn and garden only **10** Monitoring well 12 Other (Specify below)
 Was a chemical/bacteriological sample submitted to Department? Yes _____ No **(No)**; If yes, mo/day/yr sample was submitted
 Water Well Disinfected? **(No)**

5 TYPE OF BLANK CASING USED:
 1 Steel 3 RMP (SR) 5 Wrought iron 8 Concrete tile CASING JOINTS: Glued _____ Clamped _____
2 PVC 4 ABS 6 Asbestos-Cement 9 Other (specify below) Welded _____
 7 Fiberglass Threaded **(Threaded)**
 Blank casing diameter: **2** in. to **5** ft. Dia _____ in. to _____ ft. Dia _____ in. to _____ ft.
 Casing height above land surface: **0** in. weight _____ lbs./ft. Wall thickness or gauge No. **sch 40**
 TYPE OF SCREEN OR PERFORATION MATERIAL:
 1 Steel 3 Stainless steel 5 Fiberglass 8 RMP (SR) 10 Asbestos-cement
 2 Brass 4 Galvanized steel 6 Concrete tile 9 ABS 11 Other (specify) _____
 12 None used (open hole)
 SCREEN OR PERFORATION OPENINGS ARE:
 1 Continuous slot 3 Mill slot 5 Gauzed wrapped **8** Saw cut **.010** 11 None (open hole)
 2 Louvered shutter 4 Key punched 7 Wire wrapped 9 Drilled holes
 7 Torch cut 10 Other (specify) _____
 SCREEN-PERFORATED INTERVALS: From **15** ft. to **5** ft. From _____ ft. to _____ ft.
 From _____ ft. to _____ ft. From _____ ft. to _____ ft.
 GRAVEL PACK INTERVALS: From **15** ft. to **4** ft. From _____ ft. to _____ ft.
 From _____ ft. to _____ ft. From _____ ft. to _____ ft.

6 GROUT MATERIAL: 1 Neat cement 2 **(2)** Cement grout 3 Bentonite 4 Other _____
 Grout Intervals: From **0** ft. to **2** ft. From **2** ft. to **4** ft. From _____ ft. to _____ ft.
 What is the nearest source of possible contamination:
 1 Septic tank 4 Lateral lines 7 Pit privy 10 Livestock pens 14 Abandoned water well
 2 Sewer lines 5 Cess pool 8 Sewage lagoon 11 Fuel storage 15 Oil well/Gas well
 3 Watertight sewer lines 6 Seepage pit 9 Feedyard 12 Fertilizer storage 16 Other (specify below)
 13 Insecticide storage
 Direction from well? _____ How many feet? _____

FROM	TO	LITHOLOGIC LOG	FROM	TO	PLUGGING INTERVALS
0	1	TOP SOIL			
1	5	CLAY & GRAVEL			
5	12	LOOSE SAND & GRAVEL - LOOSE			
12	15	BLUE-GRAY CLAY			

7 CONTRACTOR'S OR LANDOWNER'S CERTIFICATION: This water well was **(1)** constructed, (2) reconstructed, or (3) plugged under my jurisdiction and was completed on (mo/day/year) **8/5/74** and this record is true to the best of my knowledge and belief. Kansas Water Well Contractor's License No. **354** This Water Well Record was completed on (mo/day/yr) **9/25/74** under the business name of **AGD SERVICES INC** by (signature) **Steve [Signature]**