


mw-2

1 LOCATION OF WATER WELL: Fraction SE 1/4 SE 1/4 SW 1/4 Section Number 4 Township Number T 7 S Range Number R15 **EW**

Distance and direction from nearest town or city street address of well if located within city?
407 Arizona, Holton, Kansas

2 WATER WELL OWNER: RR#, St. Address, Box # : C-Mart #9103 Attn: Omar Omar Board of Agriculture, Division of Water Resources
 City, State, ZIP Code : 9 Greenway Plaza #2810, Houston, TX 77046 Application Number:

3 LOCATE WELL'S LOCATION WITH AN "X" IN SECTION BOX:

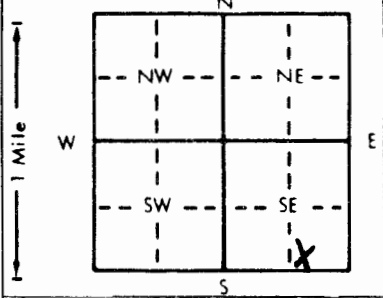

4 DEPTH OF COMPLETED WELL: 30 ft. ELEVATION: —
 Depth(s) Groundwater Encountered 1. 24.2 ft. 2. — ft. 3. — ft.
 WELL'S STATIC WATER LEVEL 24.48 ft. below land surface measured on mo/day/yr
 Pump test data: Well water was — ft. after — hours pumping — gpm
 Est. Yield — gpm: Well water was — ft. after — hours pumping — gpm
 Bore Hole Diameter: 8.625 in. to 30.0 ft. and — in. to — ft.
 WELL WATER TO BE USED AS: 5 Public water supply 8 Air conditioning 11 Injection well
 1 Domestic 3 Feedlot 6 Oil field water supply 9 Dewatering 12 Other (Specify below)
 2 Irrigation 4 Industrial 7 Lawn and garden only 10 Monitoring well mw-2
 Was a chemical/bacteriological sample submitted to Department? Yes — No X If yes, mo/day/yr sample was submitted —
 Water Well Disinfected? Yes — No X

5 TYPE OF BLANK CASING USED: 1 Steel 3 RMP (SR) 5 Wrought iron 8 Concrete tile CASING JOINTS: Glued — Clamped —
2 PVC 4 ABS 6 Asbestos-Cement 9 Other (specify below) Welded —
2 PVC 4 ABS 7 Fiberglass Threaded X

Blank casing diameter 2 in. to 19.5 ft. Dia — in. to — ft. Dia — in. to — ft.
 Casing height above land surface 0 in., weight Sch. 40 PVC lbs./ft. Wall thickness or gauge No. —

TYPE OF SCREEN OR PERFORATION MATERIAL: 7 PVC 10 Asbestos-cement
 1 Steel 3 Stainless steel 5 Fiberglass 8 RMP (SR) 11 Other (specify) —
 2 Brass 4 Galvanized steel 6 Concrete tile 9 ABS 12 None used (open hole)

SCREEN OR PERFORATION OPENINGS ARE: 5 Gauzed wrapped 8 Saw cut 11 None (open hole)
 1 Continuous slot 3 Mill slot 6 Wire wrapped 9 Drilled holes
 2 Louvered shutter 4 Key punched 7 Torch cut 10 Other (specify) —

SCREEN-PERFORATED INTERVALS: From 19.5 ft. to 29.5 ft. From — ft. to — ft.
 From — ft. to — ft. From — ft. to — ft.
 SAND GRAVEL PACK INTERVALS: From 18.5 ft. to 30 ft. From — ft. to — ft.
 From — ft. to — ft. From — ft. to — ft.

6 GROUT MATERIAL: 1 Neat cement 2 Cement grout 3 Bentonite 4 Other —
 Grout Intervals: From 0 ft. to 16.5 ft. From 16.5 ft. to 18.5 ft. From — ft. to — ft.

What is the nearest source of possible contamination:
 1 Septic tank 4 Lateral lines 7 Pit privy 10 Livestock pens 14 Abandoned water well
 2 Sewer lines 5 Cess pool 8 Sewage lagoon 11 Fuel storage 15 Oil well/Gas well
 3 Watertight sewer lines 6 Seepage pit 9 Feedyard 12 Fertilizer storage 16 Other (specify below) contaminated site
 13 Insecticide storage

Direction from well? How many feet?

FROM	TO	LITHOLOGIC LOG	FROM	TO	PLUGGING INTERVALS
GL	1.0	Concrete			Flush Mount Waiver Don Taylor 10/14/94
	1.0	Silty Clay			
	8.5	Silty Sand			
	14.3	Clayey Silt			
	18.3	Sand			
	18.3	Sand			
	33.0	Sand			
	33.0	TD			
		END OF BOREHOLE			

7 CONTRACTOR'S OR LANDOWNER'S CERTIFICATION: This water well was 1 constructed, (2) reconstructed, or (3) plugged under my jurisdiction and was completed on (mo/day/year) 1-30-95 and this record is true to the best of my knowledge and belief. Kansas Water Well Contractor's License No. 585 This Water Well Record was completed on (mo/day/yr) 4-17-95 under the business name of Associated Environmental, Inc by (signature) D. Johnson for Darin Duncan

OFFICE USE ONLY
T
R
EW
SEC
1/4
1/4
1/4