


MW 3

1 LOCATION OF WATER WELL: Fraction SE 1/4 SE 1/4 SW 1/4 Section Number 4 Township Number T 7 S Range Number R 15 EA

County: Jackson Distance and direction from nearest town or city street address of well if located within city? 407 Arizona, Holton, Kansas

2 WATER WELL OWNER: Jackson Co. Fair Board Attn: Betty Beam Board of Agriculture, Division of Water Resources
RR#, St. Address, Box # Jackson Co. Courthouse, Holton, Kansas 66436 Application Number: -----
City, State, ZIP Code

3 LOCATE WELL'S LOCATION WITH AN "X" IN SECTION BOX:

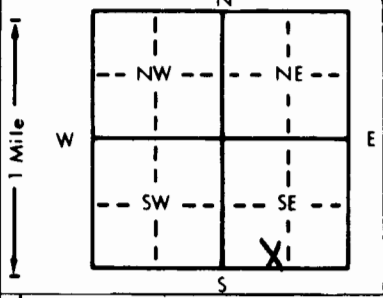

4 DEPTH OF COMPLETED WELL 25.5 ft. ELEVATION: -----
Depth(s) Groundwater Encountered 1. 20.8 ft. 2. ----- ft. 3. ----- ft.
WELL'S STATIC WATER LEVEL 22.05 ft. below land surface measured on mo/day/yr 4/4/95
Pump test data: Well water was ----- ft. after ----- hours pumping ----- gpm
Est. Yield ----- gpm Well water was ----- ft. after ----- hours pumping ----- gpm
Bore Hole Diameter 8.625 in. to 25.5 ft., and ----- in. to ----- ft.
WELL WATER TO BE USED AS: 5 Public water supply 8 Air conditioning 11 Injection well
1 Domestic 3 Feedlot 6 Oil field water supply 9 Dewatering 12 Other (Specify below)
2 Irrigation 4 Industrial 7 Lawn and garden only 10 Monitoring well MW-3
Was a chemical/bacteriological sample submitted to Department? Yes ----- No X If yes, mo/day/yr sample was submitted -----
Water Well Disinfected? Yes ----- No X

5 TYPE OF BLANK CASING USED: 1 Steel 2 PVC 3 RMP (SR) 4 ABS 5 Wrought iron 6 Asbestos-Cement 7 Fiberglass 8 Concrete tile 9 Other (specify below) 10 Asbestos-cement 11 Other (specify) 12 None used (open hole)
Blank casing diameter 2 in. to 5.5 ft. Dia ----- in. to ----- ft. Dia ----- in. to ----- ft.
Casing height above land surface 0 in. weight SCH 40 PVC lbs./ft. Wall thickness or gauge No. -----
TYPE OF SCREEN OR PERFORATION MATERIAL: 1 Steel 2 Brass 3 Stainless steel 4 Galvanized steel 5 Fiberglass 6 Concrete tile 7 PVC 8 RMP (SR) 9 ABS 10 Asbestos-cement 11 Other (specify) 12 None used (open hole)
SCREEN OR PERFORATION OPENINGS ARE: 1 Continuous slot 2 Louvered shutter 3 Mill slot 4 Key punched 5 Gauzed wrapped 6 Wire wrapped 7 Torch cut 8 Saw cut 9 Drilled holes 10 Other (specify) 11 None (open hole)
SCREEN-PERFORATED INTERVALS: From 15.5 ft. to 25.5 ft. From ----- ft. to ----- ft. From ----- ft. to ----- ft.
GRAVEL PACK INTERVALS: From 13.5 ft. to 25.5 ft. From ----- ft. to ----- ft. From ----- ft. to ----- ft.

6 GROUT MATERIAL: 1 Neat cement 2 Cement grout 3 Bentonite 4 Other -----
Grout Intervals: From 0 ft. to 11.5 ft. From 11.5 ft. to 13.5 ft. From ----- ft. to ----- ft.
What is the nearest source of possible contamination: 1 Septic tank 2 Sewer lines 3 Watertight sewer lines 4 Lateral lines 5 Cess pool 6 Seepage pit 7 Pit privy 8 Sewage lagoon 9 Feedyard 10 Livestock pens 11 Fuel storage 12 Fertilizer storage 13 Insecticide storage 14 Abandoned water well 15 Oil well/Gas well 16 Other (specify below) Contaminated site
Direction from well? How many feet? site

FROM	TO	LITHOLOGIC LOG	FROM	TO	PLUGGING INTERVALS
GL	2.00	Silty Clay			Flush Mount Wai Richard Harper 10/14/94
	2.00 16.00	Silty Clay			
	16.00 25.50	Silty Sand			
	25.50 TD	End of Borehole			

7 CONTRACTOR'S OR LANDOWNER'S CERTIFICATION: This water well was (1) constructed, (2) reconstructed, or (3) plugged under my jurisdiction and was completed on (mo/day/year) 4/5/95 and this record is true to the best of my knowledge and belief. Kansas Water Well Contractor's License No. 585 This Water Well Record was completed on (mo/day/yr) 4/17/95 under the business name of Associated Environmental, Inc. by (signature) [Signature]