


1 LOCATION OF WATER WELL: Fraction NE Section Number 23 Township Number T 7 S Range Number R 16 E
 County: JACKSON SE 1/4 SE 1/4 NE 1/4

Distance and direction from nearest town or city street address of well if located within city? 2 1/2 N 1 1/2 E of Davison

2 WATER WELL OWNER: John A. Harms
 RR#, St. Address, Box #: P.O. Box 568 Board of Agriculture, Division of Water Resources
 City, State, ZIP Code: OSKALOOSA 6606 Application Number:

3 LOCATE WELL'S LOCATION WITH AN "X" IN SECTION BOX:

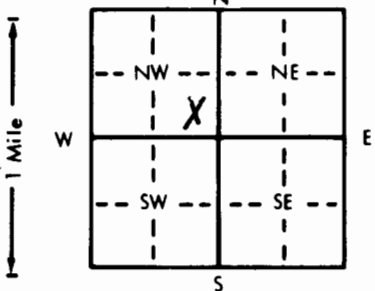

4 DEPTH OF COMPLETED WELL: 50 ft. ELEVATION: 1000 ft
 Depth(s) Groundwater Encountered 1. 14 ft. 2. _____ ft. 3. _____ ft.

WELL'S STATIC WATER LEVEL: 11 ft. below land surface measured on mo/day/yr 7-21-82
 Pump test data: Well water was _____ ft. after _____ hours pumping _____ gpm
 Est. Yield: 6 gpm: Well water was _____ ft. after _____ hours pumping _____ gpm
 Bore Hole Diameter: 8 in. to _____ in. and _____ in. to _____ in.

WELL WATER TO BE USED AS:
 1 Domestic 3 Feedlot 6 Oil field water supply 8 Air conditioning 11 Injection well
 2 Irrigation 4 Industrial 7 Lawn and garden only 9 Dewatering 12 Other (Specify below)
 5 Public water supply 10 Observation well
 Was a chemical/bacteriological sample submitted to Department? Yes _____ No ✓; If yes, mo/day/yr sample was submitted _____
 Water Well Disinfected? Yes _____ No _____

5 TYPE OF BLANK CASING USED:
 1 Steel 3 RMP (SR) 5 Wrought iron 8 Concrete tile CASING JOINTS: Glued ✓ Clamped _____
 2 PVC 4 ABS 6 Asbestos-Cement 9 Other (specify below) Welded _____
 7 Fiberglass Threaded _____

Blank casing diameter: 5 in. to 0-12 ft. Dia: 5 in. to 22-40 ft. Dia: _____ in. to _____ ft.
 Casing height above land surface: 24 in., weight: 2.82 lbs./ft. Wall thickness or gauge No. 258

TYPE OF SCREEN OR PERFORATION MATERIAL:
 1 Steel 3 Stainless steel 5 Fiberglass 7 PVC 10 Asbestos-cement
 2 Brass 4 Galvanized steel 6 Concrete tile 8 RMP (SR) 11 Other (specify) _____
 9 ABS 12 None used (open hole)

SCREEN OR PERFORATION OPENINGS ARE:
 1 Continuous slot 3 Mill slot 5 Gauzed wrapped 8 Saw cut 11 None (open hole)
 2 Louvered shutter 4 Key punched 6 Wire wrapped 9 Drilled holes
 7 Torch cut 10 Other (specify) _____

SCREEN-PERFORATED INTERVALS: From 12 ft. to 22 ft., From _____ ft. to _____ ft.
 From 90 ft. to 50 ft., From _____ ft. to _____ ft.
 GRAVEL PACK INTERVALS: From 10 ft. to 50 ft., From _____ ft. to _____ ft.
 From _____ ft. to _____ ft., From _____ ft. to _____ ft.

6 GROUT MATERIAL: 1 Neat cement 2 Cement grout 3 Bentonite 4 Other _____
 Grout Intervals: From 0 ft. to 10 ft., From _____ ft. to _____ ft., From _____ ft. to _____ ft.

What is the nearest source of possible contamination:
 1 Septic tank 4 Lateral lines 7 Pit privy 10 Livestock pens 14 Abandoned water well
 2 Sewer lines 5 Cess pool 8 Sewage lagoon 11 Fuel storage 15 Oil well/Gas well
 3 Watertight sewer lines 6 Seepage pit 9 Feedyard 12 Fertilizer storage 16 Other (specify below)
 13 Insecticide storage _____

Direction from well? NE How many feet? 180

FROM	TO	LITHOLOGIC LOG	FROM	TO	LITHOLOGIC LOG
0	2	Top soil			
2	12	Clay, brown			
12	14	Limestone, loose gray			
14	33	Shale, grey			
33	38	Limestone grey			
38	41	Shale, grey			
41	46	Limestone grey			
46	50	Shale, grey			

7 CONTRACTOR'S OR LANDOWNER'S CERTIFICATION: This water well was (1) constructed, (2) reconstructed, or (3) plugged under my jurisdiction and was completed on (mo/day/year) 4-21-82 and this record is true to the best of my knowledge and belief. Kansas Water Well Contractor's License No. 182 This Water Well Record was completed on (mo/day/yr) 5-4-82 under the business name of Strader Pkg Co Inc by (signature) Dale Ashen

INSTRUCTIONS: Use typewriter or ball point pen, PLEASE PRESS FIRMLY and PRINT clearly. Please fill in blanks, underline or circle the correct answers. Send top three copies to Kansas Department of Health and Environment, Division of Environment, Environmental Geology Section, Topeka, KS 66620. Send one to WATER WELL

OFFICE USE ONLY

T

7

R

16

EW

SEC.

23

SE

SE

1/4

1/4