79

USE TYPEWRITER OR BALL POINT PEN-PRESS FIRMLY, PRINT CLEARLY.

WATER WELL RECORD
KSA 82a-1201-1215

aac

Kansas Department of Health and Environment-Division of Environment
(Water well Contractors)
Topeka, Kansas 66620

1. Location of well:	County: Jackson	Fraction: SW NE NE 1/4	Section number: 29	Township number: T 7 S	Range number: R 16 (E) W

2. Distance and direction from nearest town or city: 2 N 1½ E
Street address of well location if in city: Denison

3. Owner of well: George McDiarmid
R.R. or street: RR. 1
City, state, zip code: Denison, Ks. 66419

4. Locate with "X" in section below:

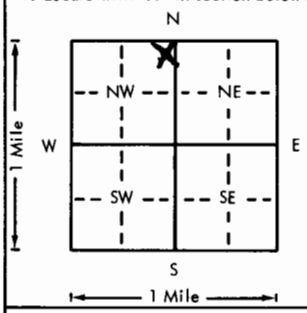

Sketch map:

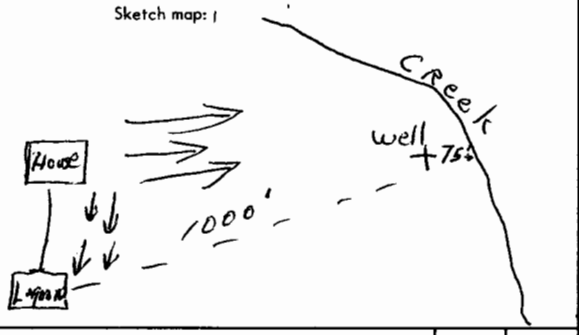

6. Bore hole dia. 8 in. Completion date 5-5-78
Well depth 76 ft.

7. __ Cable tool X Rotary __ Driven __ Dug
__ Hollow rod __ Jetted __ Bored __ Reverse rotary

8. Use: X Domestic __ Public supply __ Industry
__ Irrigation __ Air conditioning __ Stock
__ Lawn __ Oil field water __ Other

9. Casing: Material PVC; Height: Above or below
Threaded ___ Welded ___ Surface 24 in.
RMP ___ PVC Glue Weight 2.74 lbs./ft.
Dia. 5 in. to 76 ft. depth; Wall Thickness: inches or
Dia. ___ in. to ___ ft. depth; gage No. 1258

10. Screen: Manufacturer's name Pumpco
Type PVC Dia. 5"
Slot/gauze .080 Length 10'
Set between 15 ft. and 25 ft.
___ ft. and ___ ft.
Gravel pack? Yes Size range of material ⅛ x ¼

11. Static water level: mo./day/yr.
15 ft. below land surface Date 5-5-78

12. Pumping level below land surfaces: Air Test
___ ft. after ___ hrs. pumping ___ g.p.m.
___ ft. after ___ hrs. pumping ___ g.p.m.
Estimated maximum yield 2 g.p.m.

13. Water sample submitted: mo./day/yr.
___ Yes X No Date

14. Well head completion: Top Cap
___ Pitless adapter 24 Inches above grade

15. Well grouted? yes
With: X Neat cement ___ Bentonite ___ Concrete
Depth: From 0 ft. to 10 ft.

16. Nearest source of possible contamination:
ft. 75 Direction S Type Creek
Well disinfected upon completion? X Yes ___ No

17. Pump: X Not installed
Manufacturer's name
Model number ___ HP ___ Volts ___
Length of drop pipe ___ ft. capacity ___ g.p.m.
Type:
___ Submersible ___ Turbine
___ Jet ___ Reciprocating
___ Centrifugal ___ Other

5. Type and color of material

	From	To
Top Soil	0	5
Black Sandy Silt	5	10
~~Black Sandy Silt~~	~~10~~	~~18~~
Brown Sandy Cherty Clay	10	18
Brown Muddy Chert	18	23
Gray Shale	23	44
Gray limestone	44	47
Gray Shale	47	80

(Use a second sheet if needed)

18. Elevation: 1020
Topography:
___ Hill
___ Slope
X Upland
___ Valley

19. Remarks:
owner to install slab

20. Water well contractor's certification:
This well was drilled under my jurisdiction and this report is true to the best of my knowledge and belief.
Strader Drlg Co Inc. 182
Business name License No.
Address RT 1 Holton, Ks
Signed Dale Ashum Date 5-8-78
Authorized representative

7 T 16 (E) W R 29 Sec NE NE NW 1/4 1/4 1/4

Forward the white, blue and pink copies to the Department of Health and Environment

Form WWC-5

BR = 997 ▽ = 1005