


1 LOCATION OF WATER WELL: County: JACKSON	Fraction NW ¼ NE ¼ SW ¼	Section Number 33	Township Number T 7 S	Range Number R 16 EW
--	----------------------------	----------------------	--------------------------	-------------------------

Distance and direction from nearest town or city street address of well if located within city?
1/2 mile west, 1/2 mile north of Denison

2 WATER WELL OWNER: Gary Bohnenkemper
RR#, St. Address, Box #: Rt. 1 Box 47
City, State, ZIP Code: Denison, KS 66419
Board of Agriculture, Division of Water Resources
Application Number:

3 LOCATE WELL'S LOCATION WITH AN "X" IN SECTION BOX:

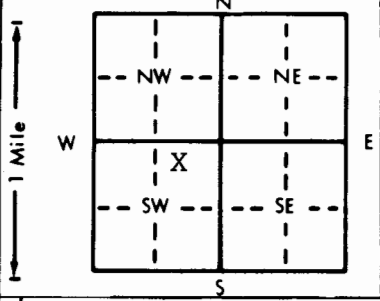

4 DEPTH OF COMPLETED WELL: 80 ft. ELEVATION: ft.
Depth(s) Groundwater Encountered 1. 16' ft. 2. ft. 3. ft.
WELL'S STATIC WATER LEVEL: 14' ft. below land surface measured on mo/day/yr 1-18-90
Pump test data: Well water was ft. after hours pumping gpm
Est. Yield: 1/2 gpm: Well water was ft. after hours pumping gpm
Bore Hole Diameter: 8 3/4 in. to ft., and in. to ft.
WELL WATER TO BE USED AS:
5 Public water supply 8 Air conditioning 11 Injection well
1 Domestic 3 Feedlot 6 Oil field water supply 9 Dewatering 12 Other (Specify below)
2 Irrigation 4 Industrial 7 Lawn and garden only 10 Monitoring well
Was a chemical/bacteriological sample submitted to Department? Yes.....No.....; If yes, mo/day/yr sample was submitted
Water Well Disinfected? Yes X No

5 TYPE OF BLANK CASING USED:
1 Steel 3 RMP (SR) 5 Wrought iron 8 Concrete tile CASING JOINTS: Glued X Clamped
2 PVC 4 ABS 6 Asbestos-Cement 9 Other (specify below) Welded
7 Fiberglass Threaded

Blank casing diameter: 5" in. to 0-14 ft., Dia 5" in. to 24-79 ft., Dia in. to ft.
Casing height above land surface: 24" in., weight 2.82 lbs./ft. Wall thickness or gauge No. 258

TYPE OF SCREEN OR PERFORATION MATERIAL:
1 Steel 3 Stainless steel 5 Fiberglass 7 PVC 10 Asbestos-cement
2 Brass 4 Galvanized steel 6 Concrete tile 8 RMP (SR) 11 Other (specify)
12 None used (open hole)

SCREEN OR PERFORATION OPENINGS ARE:
1 Continuous slot 3 Mill slot 5 Gauzed wrapped 8 Saw cut 11 None (open hole)
2 Louvered shutter 4 Key punched 6 Wire wrapped 9 Drilled holes
7 Torch cut 10 Other (specify)

SCREEN-PERFORATED INTERVALS: From 14 ft. to 24 ft., From ft. to ft.
From 79 ft. to 80 ft., From ft. to ft.
GRAVEL PACK INTERVALS: From 13 ft. to 80 ft., From ft. to ft.
From ft. to ft., From ft. to ft.

6 GROUT MATERIAL: 1 Neat cement 2 Cement grout 3 Bentonite 4 Other hole plug
Grout Intervals: From 0 ft. to 13 ft., From ft. to ft., From ft. to ft.

What is the nearest source of possible contamination:
1 Septic tank 4 Lateral lines 7 Pit privy 10 Livestock pens 14 Abandoned water well
2 Sewer lines 5 Cess pool 8 Sewage lagoon 11 Fuel storage 15 Oil well/Gas well
3 Watertight sewer lines 6 Seepage pit 9 Feedyard 12 Fertilizer storage 16 Other (specify below)
13 Insecticide storage
Direction from well? West How many feet? 118'

FROM	TO	LITHOLOGIC LOG	FROM	TO	PLUGGING INTERVALS
0	3	Top Soil			
3	13	Clay-Brown			
13	16	Coarse Sand-Med-Pea Gravel, Brown			NOTE: 1-29-90 Received permission from Don Taylor to grout to 13'
16	30	Shale-Grey			
30	34	Limestone-Grey			
34	51	Shale-Grey			
51	53	Limestone-Grey			
53	71	Shale-Grey			
71	75	Limestone-Grey			
75	80	Shale-Grey			

7 CONTRACTOR'S OR LANDOWNER'S CERTIFICATION: This water well was (1) constructed, (2) reconstructed, or (3) plugged under my jurisdiction and was completed on (mo/day/year) 1-18-90 and this record is true to the best of my knowledge and belief. Kansas Water Well Contractor's License No. 182 This Water Well Record was completed on (mo/day/yr) 2-7-90 under the business name of STRADER DRILLING CO., INC. by (signature) Dale Strader

OFFICE USE ONLY
T
R
EW
SEC.