16

USE TYPEWRITER OR BALL POINT PEN-PRESS FIRMLY, PRINT CLEARLY.

T R EW sec 1/4 1/4 1/4 No.

WATER WELL RECORD
KSA 82a-1201-1215

Kansas State Dept. Of Health
(Water Well Contractors)
Forbes-Bldg. 740
Topeka, Kansas 66620

1 Location of well:	County	Township name	Fraction	Section number	Town number	Range number
	JACKSON	Garfield	N½ - SE¼	34	7S	16E

Distance and direction from nearest town or city: 1mi. E ¼ N of
Street address of well location if in city: Denison, KANSA

3 Owner of well: Paul EuBanKS
Address: RR Denison

Locate with "X" in section below:

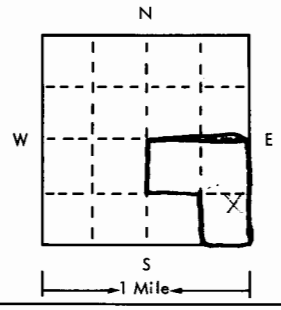

Sketch map:

250' x 300'

4 Well depth: 59' ft. Date of completion
Well diameter 8 in. 3-19-75

5 ☐ Cable tool ☒ Rotary ☐ Driven ☐ Dug
☐ Hollow rod ☐ Jetted ☐ Bored ☐ Reverse rotary

6 Use: ☒ Domestic ☐ Public supply ☐ Industry
☐ Irrigation ☐ Air conditioning ☐ Commercial
☐ Test well ☐

7 Casing: Material PVC Height: above/below
Threaded ☐ Welded ☐ Surface 24 in.
Diam. Weight 1.33 lbs./ft.
5 in. to 59 ft. depth Drive shoe? ☐ Yes ☐ No
in. to ft. depth

2

Type and color of material	From	To
Top Soil	0	3
Sandy Brown Clay	3	18
Sand Stone	18	36
Cemented Gravel	36	38
Blue Shale	38	48
Blue Rock	48	52
Blue Shale	52	60

(use a second sheet if needed)

8 Screen:
Manufacturer Pumpco.
Type PVC Dia. 5"
Slot/~~gauze~~ .080 Length 20'
Set between 20 ft. and 40 ft.
Fittings:
Gravel pack ☒ Yes ☐ No Size range of material ¼x8

9 Static water level: NOT MEASURED
ft. below land surface Date

10 Pumping level below land surfaces:
ft. after hrs. pumping g.p.m.
ft. after hrs. pumping g.p.m.
Estimated maximum yield 8 g.p.m.

11 Water sample submitted:
☐ Yes ☒ No Date

12 Well head completion:
☐ Pitless adapter 24 ☐ Inches above grade

13 Well grouted? ☒ Yes ☐ No
☒ Neat cement ☐ Bentonite ☐
Depth: From 0 ft. to 10 ft.

14 Nearest source of possible contamination:
ft. 100 Direction N E Type Septic Tank
Well disinfected upon completion? ☒ Yes ☐ No

15 Pump: ☒ Not installed
Manufacturer's name
Model number HP Volts
Length of drop pipe ft. capacity g.m.p.
Type:
☐ Submersible ☐ Turbine
☐ Jet ☐ Reciprocating
☐ Certrifugal ☐ Other

16 Remarks: elevation
1455'
Topography:
☐ Hill
☐ Slope
☒ Upland
☐ Valley

17 Water well contractor's certification:
This well was drilled under my jurisdiction and this report is true to the best of my knowledge and belief.
Strader Drilling Co. Inc. #182
Business name License No.
Address RR1-Hy.75 N Holton, KANS
Signed Dale Cakes Date 3-24-75
Authorized representative

Forward the white, blue and pink copies to the Kansas State Dept. Of Health.

Form WWC-5